

KANSAS


FORM 51 5M 10-41 PETROL

Brown

Section 24 Township 4- Range 16-E

Well No. 4 Stratigraph

Company Carter Oil

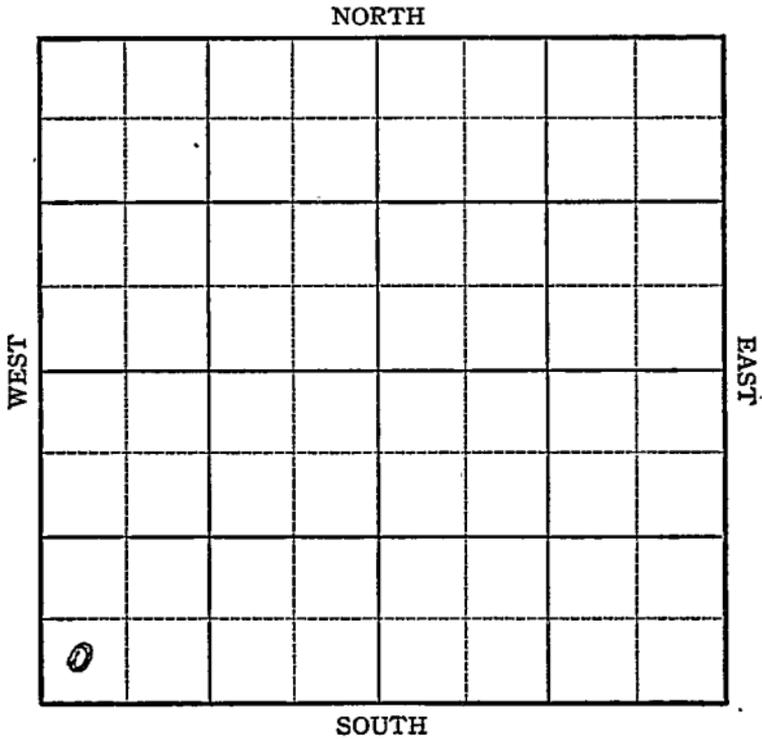

13

KANSAS

Brown

Sec. 24 Twp. 4 R. 16-E

Well No. #4 Stratigraph Farm


Carter Oil Company

_____ Ft. from N. Line

330 Ft. from S. Line

330 Ft. from E. Line

_____ Ft. from W. Line

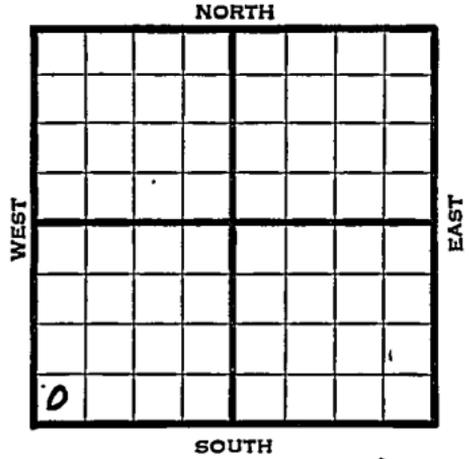

1941	Elev. 1112' REPORT
12/3	Miss. 2163'
	Kinderhook Shale 2445'
	Hunton 2676'
	Viola 3196'
	Simpson 3360'
	Arb. 3444'
	T.D. 3500' No shows.
	FIRST REPORT
	<i>and</i> ABANDONED

$$\begin{array}{r} 2676 \\ 2163 \\ \hline 5112 \end{array}$$

$$\begin{array}{r} 3360 \\ 2676 \\ \hline 6036 \end{array}$$

$$\begin{array}{r} 3360 \\ 1112 \\ \hline 4472 \end{array}$$

Brown

KANSAS

Map No. 111 Sec. 24 Twp. 4 R. 16EWell No. 4 StratigraphCarter Oil Company
FIRST REPORTCOMPLETED Contractor

SW/C

SECTION PLAT

 Ft. from N. Line330 Ft. from S. Line330 Ft. from E. Line Ft. from W. LineLocation Rig up

Drilling and Remarks:

No shows

RECORD

Cased in., ft.Sand Gas Oil Total Depth 3500

PRODUCTION

1st 24 hrs. Nat. 1st 24 hrs. after shot Gas Cu. Ft.Dry Hole Abandoned

Date

DEC 3 1941 19 S. I. LEWIS Scout

Carter Oil #4 Stratigraph Test
El. 1112', SW/C 24-4-16E, Brown County.

Mississippi	2163'
Kinderhook Shale	2445'
Hunton	2676'
Viola	3196'
Simpson	3360'
Arbuckle	3444'
Total Depth	3500'
	No shows