


Map No. W1110AS Sec. 4 Twp. 4S R. 7E
 Well No. 1- Finn Farm
Marshall oil Synd Company

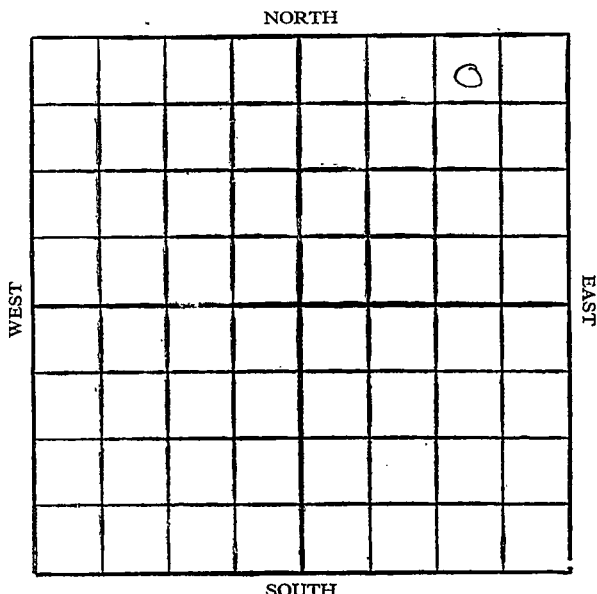

Location

Drilling Remarks

Rig Up.....

Drilling Remarks

RECORD

Cased in. ft.

Sand

Gas

Oil

Total Depth

PRODUCTION

1st 24 hrs. Nat.

1st 24 hrs. after shot

Gas cu. ft.

Dry Hole

Abandoned

Map No. _____ Sec. 4 Twp. 4 S R 7 EWell No. 1 - Finn Farm
Marshall Oil Synd Company


NORTH

330 Ft. from N. Line

_____ Ft. from S. Line

990 Ft. from E. Line

_____ Ft. from W. Line

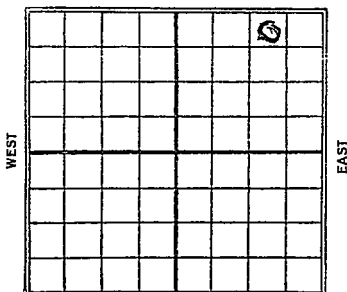

SOUTH

1927

Date

REPORT

6/29	Sand 1800-1810 Shale break 1810-11 Sand 1811-12' Rainbow show oil S.D. for orders
7/7	Dry sand 1800-1810 Shale break 1810-11' Sandy line 1811-1824 rainbow show from 1811-12' S.D. 1824
7/13	U.R. 8" T.D. 1950
7/20	—
7/28	—
8/4	Dry sand 1800-1810' shale break 1810-11' sandy line 1811-1824 rainbow show 1811-12 U.R. 8" T.D. 1950'
8/10	—
8/18	—
8/24	Green shale 2070-2125 - 6'-2125- dng 2140-

9/1
9/7 - Shut down 2140

9/14

9/29

10/6

10/12

10/19

10/27 - Dry sand 1800-1810

Shale break 1810-11

Sdy lime 1811-1824

rainbow show from

1811-12' green shale

2070-2125 S.D. 2140

11/2

11/9 - Shut down 2140.

11/16

11/23

11/30 Drlg 2485'

12/7 - S.D. 2485'

12/14 -

12/21

12/29

1/5

1/11 - St. Reaming 2610'

1/18

1/26

2/2

2/9

2/16 - Drlg 2700-

2/23

3/1

3/8

3/16 - Shut down 2700

3/22

3/29

4/12 - N+Q. 2640

100 ft. 26-1M Bks. 3-23-11959.

Marshall

KANSAS

Map No. _____ Sec. 4 Twp. 4 R. 7^E

Well No. 1 Linn

Marshall Oil Synd Company

Contractor

COMPLETED

SECTION PLAT

330 Ft. from N. Line

_____ Ft. from S. Line

990 Ft. from E. Line

_____ Ft. from W. Line

			0

ABANDONED

Location _____

Rig up _____

Drilling and Remarks:

to 1800-1810
Shaw Bks 1810-11
to 1811-12 Rainwater
Shale
Shale 1870-1875
DOA 18640

RECORD

Cased _____ in., _____ ft.

Sand _____

Gas _____

Oil _____

Total Depth 7640

PRODUCTION

1st 24 hrs. Nat. _____

1st 24 hrs. after shot _____

Gas _____ Cu. Ft.

Dry Hole ☒

Abandoned ☒

Date

APR 12 1928

CHAS. L. SHERWOOD

Scout

no well receipt
no small receipt
X

Returned	
Cards	
Tracing	<i>None</i>
France Map	
Scarborough Map	X
Moody Map	
Scarborough Flat Book	
Moody Flat Book	

no m **KANSAS**Map No. _____ Sec. 4 Twp. 4^S R. 7Well No. 1 FinnMarshall Oil Syndicate Company

Contractor _____

FIRST REPORTS330

Ft. from N. Line

Ft. from S. Line

990

Ft. from E. Line

Ft. from W. Line

SECTION PLAT

			0

Location _____

Rig up _____

Drilling and Remarks:

Sand 1800-1810'Shale breaks 1810-11'Sand 1811-12'Rainbow show oil515 for orders.

Date

June 29, 1927**RECORD**

Cased _____ in., _____ ft.

Sand _____

Gas _____

Oil _____

Total Depth _____

PRODUCTION

1st 24 hrs. Nat. _____

1st 24 hrs. after shot _____

Gas _____ Cu. Ft.

Dry Hole _____

Abandoned _____

CHAS. L. SHERWOOD

Scout

No 5 small Map
No wall Map

Returned	
Cards	 <i>mmmm</i>
Tracing	 <i>None</i>
France Map	
Scarborough Map	 <i>X</i>
Moody Map	
Scarborough Flat Book	
Moody Flat Book	