

15117000290000

FORM 51 10M 8-47

Marshall

KANSAS


Section 4 Township 4 Range 7EWell No. #1 MarvinCompany H J Uhl etal.

Wildcat

NORTH

WEST

EAST

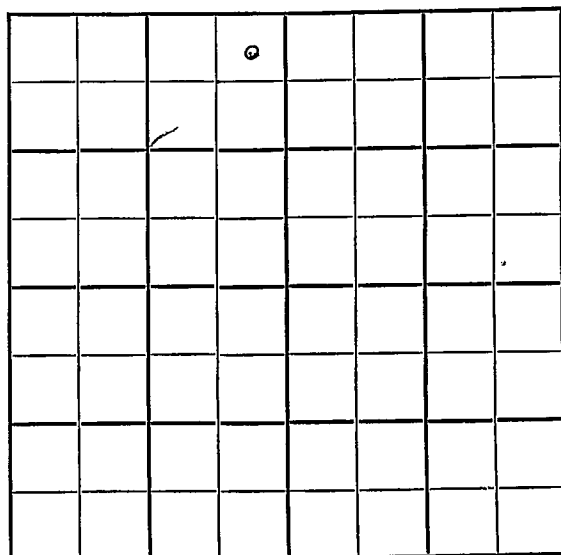

SOUTH

3

KANSAS

Marshall

Sec. 4 Twp. 4 R. 7E

Well No. #1 Marvin Farm
H. J. Uhl et al Company

Wildcat


330' Ft. from N. Line

Ft. from S. Line

330' Ft. from E. Line

Ft. from W. Line

NE NW

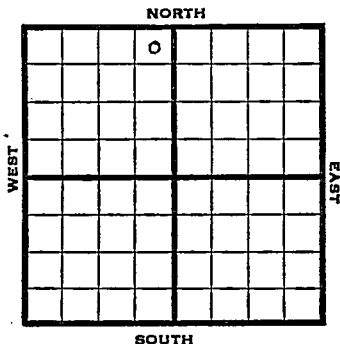

1948

Elev. 1828' REPORT

3/31 Surface Hole

4/7 8" @ 100'
Drlg. 920'

4/14 Viola 1830'
TD 1875'
Abd.

ABANDONED

Map No. 12A Sec. 4 Twp. 4 R. 7E

Well No. 1 Marvin

H. J. Uhl et al. Company

ABANDONED Contractor

NE NW

E. 1828
SECTION PLAT

330 Ft. from N. Line

 Ft. from S. Line

330 Ft. from E. Line

 Ft. from W. Line

Marshall County

Location

Rig up

Drilling and Remarks:

Vista 1830

RECORD

Cased in., ft.

Sand

Gas

Oil

Total Depth 1825

PRODUCTION

1st 24 hrs. Nat.

1st 24 hrs. after shot

Gas Cu. Ft.

Dry Hole

Abandoned

Date

APR 14 1948

 19 S. J. LEWIS Scout

Map No. _____ Sec. 4 Twp. 4 R. 7E

Well No. 1 Marvin

H. J. Uhl et al. Company

FIRST REPORT Contractor

NE NW


SECTION PLAT

330 Ft. from N. Line

_____ Ft. from S. Line

330 Ft. from E. Line

_____ Ft. from W. Line

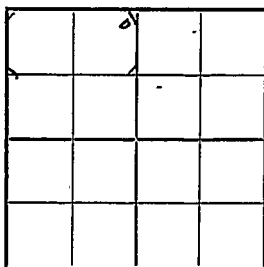

Marshall County

Location _____

Rig up _____

Drilling and Remarks:

surface hole

RECORD

Cased _____ in., _____ ft.

Sand _____

Gas _____

Oil _____

Total Depth _____

PRODUCTION

1st 24 hrs. Nat. _____

1st 24 hrs. after shot _____

Gas _____ Cu. Ft.

Dry Hole _____

Abandoned _____

Date

MAR 31 1948 19

S. J. LEWIS Scout