


KANSAS Brown

FORM 51 5M PETROL

Section 5 Township 4 Range 15-E

Well No. #1 Dillaplain

Company Call & Towle

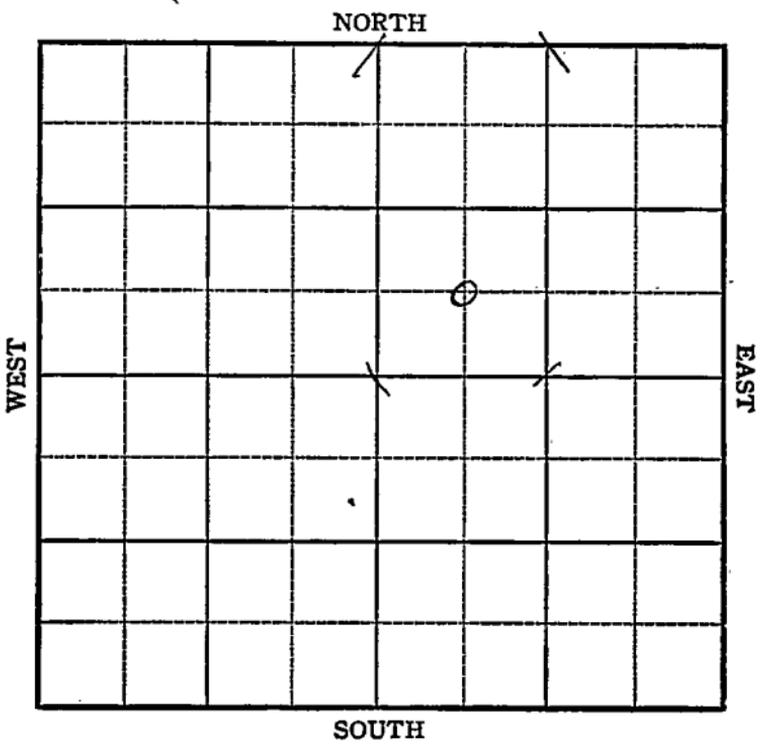

7

Sec. 5 Twp. 4 R. 15-E

Well No. #1 Dillaplain Farm

Gall & Towle Company


\_\_\_\_\_ Ft. from N. Line

660 Ft. from S. Line

\_\_\_\_\_ Ft. from E. Line

660 Ft. from W. Line

*- Elev. 1210*

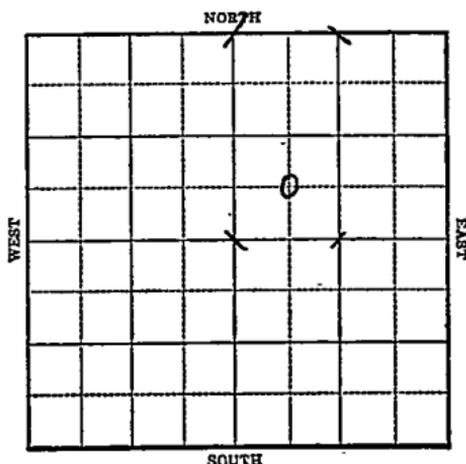

R E P O R T

1943

9/15 Derrick Phillips farmout

9/22 8" @ 180'

9/29 KC 1237  
Drlg. 1490'

10/6 BKC 1578  
Miss 2561  
Drlg. 2630'

10/13 B. Miss 2695  
Hunton 2995  
No shows  
T.D. 3045'

*2561  
1578  
-----  
993*

*2995  
2561  
-----  
434*

ABANDONED

**KANSAS**

Map No. 122 Sec. 5 Twp. 4 R. 15E

Well No. 1 Dillanlain

Gall & Towle Company

ABANDONED Contractor

C SW NE

**SECTION PLAT**

\_\_\_\_\_ Ft. from N. Line

660 Ft. from S. Line

\_\_\_\_\_ Ft. from E. Line

660 Ft. from W. Line

		o	

Wildest Phillips farm-out

Location \_\_\_\_\_

Rig up \_\_\_\_\_

Drilling and Remarks:

*Basis 2695*

*Hutton 2995*

*No show*

**RECORD**

Cased \_\_\_\_\_ in., \_\_\_\_\_ ft.

Sand \_\_\_\_\_

Gas \_\_\_\_\_

Oil \_\_\_\_\_

Total Depth 3045

**PRODUCTION**

1st 24 hrs. Nat. \_\_\_\_\_

1st 24 hrs. after shot \_\_\_\_\_

Gas \_\_\_\_\_ Cu. Ft.

Dry Hole \_\_\_\_\_

Abandoned \_\_\_\_\_

Date

OCT 13 1943 19

S. J. LEWIS Scout

Brown

**KANSAS**

Map No. 122 Sec. 5 Twp. 4 R. 15E

Well No. 1 Dillaplain

Gall & Towle Company

**FIRST REPORT**

Contractor

C SW NE


**SECTION PLAT**

\_\_\_\_\_ Ft. from N. Line

660 Ft. from S. Line

\_\_\_\_\_ Ft. from E. Line

660 Ft. from W. Line

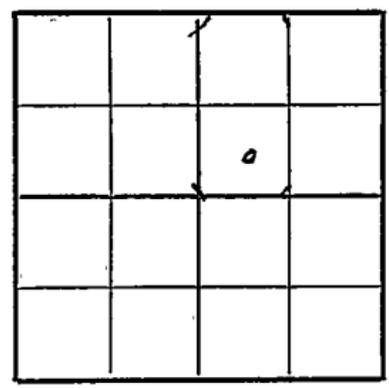

Wildcat

Location \_\_\_\_\_

Rig up \_\_\_\_\_

Drilling and Remarks:

Derrick  
Phillips  
farmout

**RECORD**

Cased \_\_\_\_\_ in., \_\_\_\_\_ ft.

Sand \_\_\_\_\_

Gas \_\_\_\_\_

Oil \_\_\_\_\_

Total Depth \_\_\_\_\_

**PRODUCTION**

• 1st 24 hrs. Nat. \_\_\_\_\_

1st 24 hrs. after shof \_\_\_\_\_

Gas \_\_\_\_\_ Cu. Ft.

Dry Hole \_\_\_\_\_

Abandoned \_\_\_\_\_

Date

SEP 15 1943 19

S. J. LEWIS Scout