

1501300010000

FORM 51 25M 8-50 WESTERN Brown

KANSAS

Section 6 Township 4 Range 15 E

Well No. # 1 Spiker

Company Woods Oil & Gas

NORTH

	0						

WEST

EAST

SOUTH

4

Brown

KANSAS ✓

Sec. 6 Twp. 4 R. 15 E

Well No. # 1 Spiker Farm _____

Woods Oil & Gas Company _____

Woods Oil & Gas Contractor _____

Wildcat


330 Ft. from N. Line

_____ Ft. from S. Line

_____ Ft. from E. Line

990 Ft. from W. Line

NE NW NW
Carter Farmout

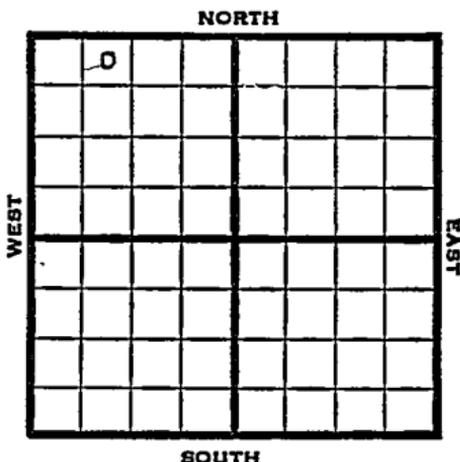

1951 Elev. 1193' REPORT

6/27 Spud 6-23-51
8" @ 131'

7/18 Spud 6-23-51
D & A TD 3708'
8" @ 131 Lans. 1380' B KC 1708'
Miss 2572' Kinderhook 2709'
Hunton 2991' Maq. 3502' Viola 3597'
TD 3708' D & A

ABANDONED

2991
2572

419

County Brown State Kansas

Sec. 6 (Blk. 4 (Sur. 15E (Twp.) Map No.

Operator Woods Oil & Gas

Well No. 1 Farm Spiker

Elev. _____ Location NE NW NW

o					
FIRST REPORT					

330 Ft. From N Line NW

990 Ft. From W Line Quarter

Ist. Report JUN 27 1951

Completion _____

Remarks Carter - F.O.

Woods Oil & Gas - Contr.

Spudding Date 6-23-51

Drig. Data Wildcat

8" @ 131'

J. E. TYRA

County Brown State Kansas

Sec. 6 (Blk. 4 (Twp.) (Sur. 15E (Rge.) Map No.

Operator Wood Oil & Gas

Well No. 1 Farm Spiker

Elev. 1193 Location NE NW NW

o					

330 Ft. From N Line NW

990 Ft. From W Line Quarter

Ist. Report

Completion JUL 18 1951

Remarks Wildcat

Wood Oil & Gas - Contr.

Spudding Date 6-23-51

ABANDONED

Drlg. Data D & A TD 3708

8" @ 131 Lans. 1380 B KC 1708

Miss. 2572 Kinderhook 2709 Hunton 2991

Maq. 3502 Viola 3597 TD 3708

D & A

J. E. TYRA