

5117000020000

KANSAS


FORM 51

Marshall

Section 9 Township 4 Range 10E

Well No. I Fischer

Company Kansas Oil Company

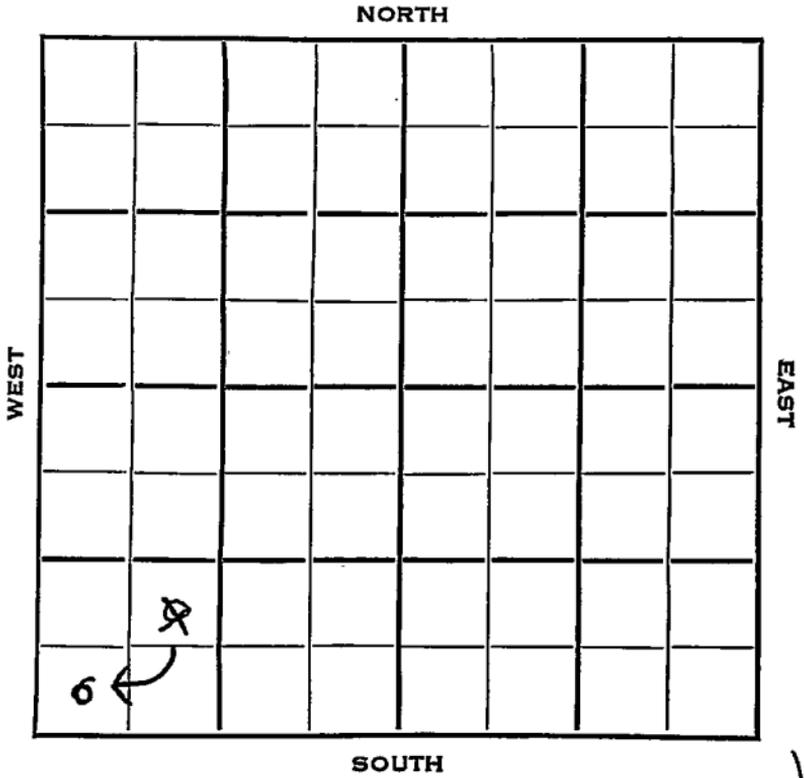

13

Sec. 9 Twp. 4 R. 10E

Well No. #1 Fischer Farm

Kansas Oil Co. Company

Wildcat Contractor

Ft. from N. Line

330

Ft. from S. Line

990


Ft. from E. Line

330

Ft. from W. Line

990

SW
NE SW SW

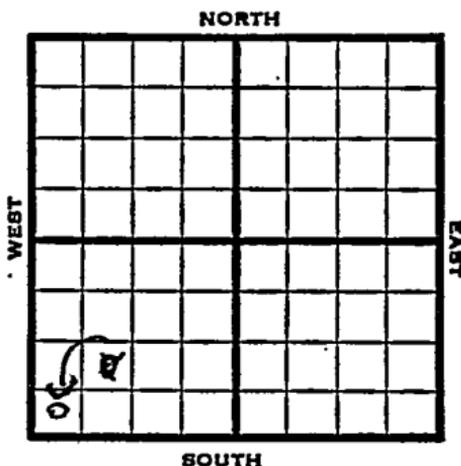

1953 Elev. - REPORT

1/14 Spud 12-12-52
12" @ 110
10" @ 300
8" @ 980

2/11 Drlg. 1000'
Spud 12-12-52
D&A
TD 1117'
12" @ 110
10" @ 300
8" @ 980
Granite 1110
TD 1117'
D&A

ABANDONED

Kansas

Map No. _____ Sec. 9 Twp. 4 R. 10E

Well No. 1 Fischer

Kansas Oil Co. Company

CORRECTION Contractor

SW SW SW

SECTION PLAT

_____ Ft. from N. Line

330 Ft. from S. Line

_____ Ft. from E. Line

330 Ft. from W. Line

Marshall County

RECORD

Location _____

Cased _____ in., _____ ft.

Rig up _____

Sand _____

Drilling and Remarks:

Gas _____

Oil _____

Total Depth _____

Reported

NE SW SW

PRODUCTION

1st 24 hrs. Nat. _____

1st 24 hrs. after shot _____

Gas _____ Cu. Ft.

Dry Hole _____

Abandoned _____

Date _____

FEB 11 1953 19

J. G. MCGHEE

Scout

