

15131000230000

FORM 51 25M 8-50 WESTERN

Nemaha

KANSAS

Section 23 Township 5 Range 13EWell No. 1 GriffithCompany Wood Oil

NORTH

							0

WEST

EAST

SOUTH

Nemaha

ANSAS

Sec. 23 Twp. 5 R. 13 E.

Well No. # 1 Griffith Farm

Wood Oil Company

Contractor

Wildcat


990 Ft. from N. Line

 Ft. from S. Line

330 Ft. from E. Line

 Ft. from W. Line

SE NE NE
Carter DHM

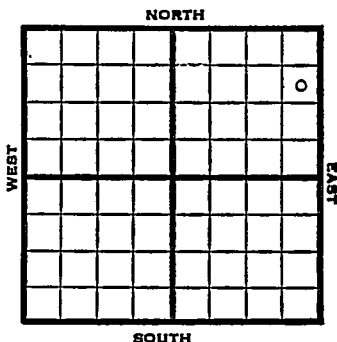

1951

Elev. 1341' REPORT

7/25

Spud 7-22-51
8" @ 200 WOG

8/8

Spud 7-22-51
D&A TD 3979
8" @ 200'

Lans. 1450 BKG 1785

Miss 2726 Kh 2808

Hunton 3072 Maq 3626

Vi la 3686 Simp 3855

St. Peter 3890

Arb. 3928 Regan 3961

Granite 3971-79 TD

D&A

ABANDONED

$$\begin{array}{r} 2726 \\ 1785 \\ \hline 941 \end{array}$$


$$\begin{array}{r} 3072 \\ 2726 \\ \hline 346 \end{array}$$

$$\begin{array}{r} 3890 \\ 3072 \\ \hline 818 \end{array}$$

$$\begin{array}{r} 3890 \\ 1341 \\ \hline -2549 \end{array}$$

$$\begin{array}{r} 1785 \\ 1341 \\ \hline 444 \end{array}$$

County Nemaha State Kansas
 Sec. 23 (Blk.
Twp.) 5 (Sur.
Rge.) 13E Map No.
 Operator Wood Oil
 Well No. 1 Farm Griffith
 Elev. 1341 Location SE NE NE

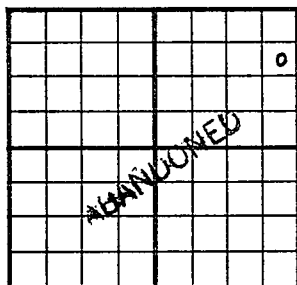

990 Ft. From N Line NE
330 Ft. From E Line Quarter
 Ist. Report
 Completion AUG 8 1951
 Remarks Wildcat

Drilg. Data D & A TD 3979

8" @ 200 Lans. 1450 R KC 1785

Miss. 2726 Kh. 2808 Hunton 3072

Maq. 3626 Viola 3686 Simp. 3855

St. Peter 3890 Arb. 3928 Regan 3961

Granite 3971-79 TD

D & A

J. E. TYRA

County Nemaha State Kansas
 Sec. 23 (Blk.) 5 (Sur.) 13E Map No.
 Operator Wood Oil
 Well No. 1 Farm Griffith
 Elev. _____ Location SE NE NE

FIRST REPORT

990 Ft. From N Line NE
330 Ft. From E Line Quarter

1st. Report JUL 25 1951

Completion _____

Remarks _____

Carter DEM

Spudding Date 7-22-51

Wildcat

Drlg. Data _____

8" @ 200 WOC

J. E. TYRA