

KANSAS


Atchison

FORM 51 5M 10-41 PETROL

Section 10 Township 6 Range 19-E

Well No. 3 Stratigraphic Test

Company Carter oil

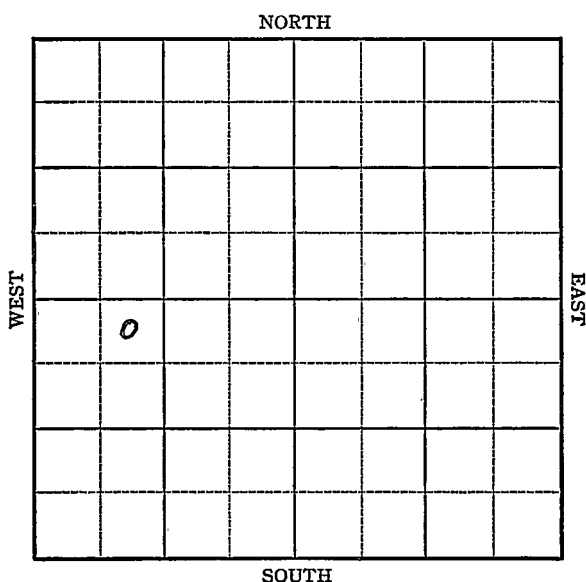

12

KANSAS

Atchison


Sec. 10 Twp. 6 R. 19-E
Well No. #3 Stratigraphic Test Farm
Carter Oil Company

330 Ft. from N. Line

Ft. from S. Line

Ft. from E. Line

990 Ft. from W. Line

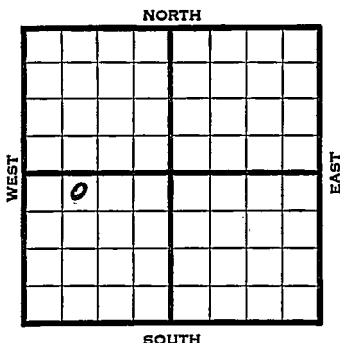

1941 Elev. 1109' REPORT

12/3 Miss. 1784'

Kinderhook 2135'

Hunton 2255'

Magnoketa 2545'

Viola 2651'

Simpson 2828'

Arb. 2894'

T.D. 2945' No shows.

1784
1109
+ 675

FIRST REPORT

and
ABANDONED

2255
1784
471

Miss - 675

2135
1109
1026

Kind - 1026

2828
2255
573

Hunt - 1146

2255
1109
1146

Magn - 1436

2545

2828
1109
1719

Viola - 1542

1109
1436

Simp - 1719

2651
1109
1542

2894

2894

Arb. - 1785

1109
1785

1109
1785

2828
1109
1719

Atchison **KANSAS**Map No. MM Sec. 10 Twp. 6 R. 19EWell No. 3 Stratigraphic Test~~First Report~~ First Garter Oil CompanyCOMPLETED Contractor

NE NW SW

SECTION PLAT

330 Ft. from N. Line Ft. from S. Line Ft. from E. Line990 Ft. from W. Line

o			

Location Rig up

Drilling and Remarks:

No shows

RECORD

Cased in., ft.Sand Gas Oil Total Depth 2945

PRODUCTION

1st 24 hrs. Nat. 1st 24 hrs. after shot Gas Cu. Ft.Dry Hole Abandoned

Date

DEC 3 1941 19 S. J. LEWIS Scout

Carter Oil #3 Stratigraph Test
El. 1109', NE NW SW 10-6-19E, Atchison
County.

Mississippi	1784'
Kinderhook	2135'
Hunton	2255'
Magnoketa	2545'
Viola	2651'
Simpson	2828'
Arbuckle	2894'
Total Depth	2945'
	No Shows