

15003 00007 0000

Form 51-5M-11-38-Palace


Atchison KANSAS

Section 17 Township 6 Range 20-E

Well No. #1 National Life

Company Wakefield et al

Wildcat

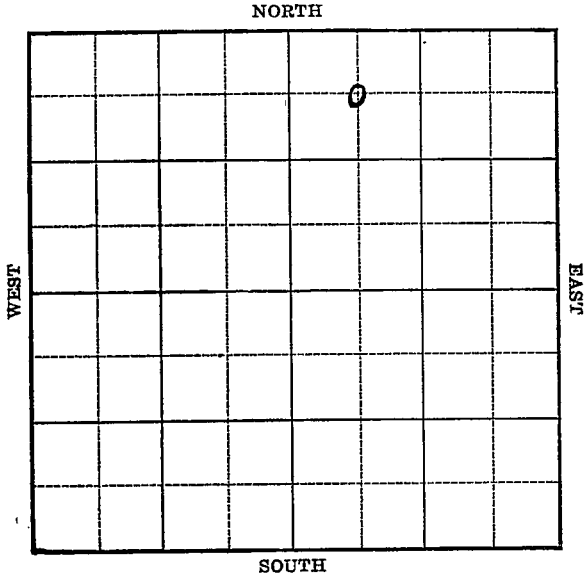

2

Use 65-19^E
Cxtion #1.

Sec. 17 Twp. 6 R. 20-E

Well No. #1 National Life Farm

Wakefield et al Company


(Wildcat)

660 Ft. from N. Line

 Ft. from S. Line

 Ft. from E. Line

660 Ft. from W. Line

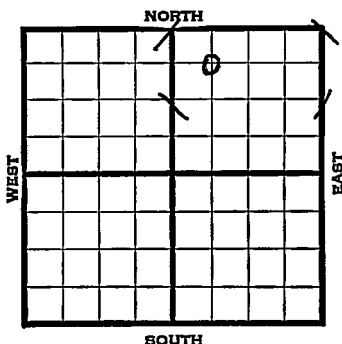

1939	REPORT
5/31	Location
6/8	" "
6/16	Cable Rig.
6/23	" "
6/29	" "
7/6	15" - 200' Drlg.
7/13	15" - 233' Drlg. 240'
7/20	12" - 900' Drlg. 1055'
7/27	10" - 1400' Drlg. 1740'
8/3	Drlg. 2060'
8/10	8" - 2155' Drlg. 2355'
8/17	Hunton 2640' Base Hunton 2647'
	Drlg.
8/23	Arb. 2750'
	7" - 2675'
	T.D. 2790'
	H.F.W.
	ABANDONED

Map No. NM Sec. 17 Twp. 6 R. 20EWell No. 1 National LifeWakefield etal

Company

Contractor

FIRST REPORT

C NW NE

660 Ft. from N. Line

_____ Ft. from S. Line

_____ Ft. from E. Line

660 Ft. from W. Line

SECTION PLAT

WILDCAT

Location X

Rig up _____

Drilling and Remarks:

RECORD

Cased _____ in., _____ ft.

Sand _____

Gas _____

Oil _____

Total Depth _____

PRODUCTION

1st 24 hrs. Nat. _____

1st 24 hrs. after shot _____

Gas _____ Cu. Ft.

Dry Hole _____

Abandoned _____

Date

MAY 31 1939

19

S. J. LEWIS

Scout

Map No. NM Sec. 17 Twp. 6 R. 20EWell No. 1 National LifeW. K. Bejfield & Co. Company

Contractor

C. W. N. E.

ABANDONED

660 Ft. from N. Line

_____ Ft. from S. Line

_____ Ft. from E. Line

660 Ft. from W. Line

SECTION PLAT

		o	

W. K. Bejfield & Co.

Location _____

Rig up _____

Drilling and Remarks:

Ca # 275-07" C 2675ANW

RECORD

Cased _____ in., _____ ft.

Sand _____

Gas _____

Oil _____

Total Depth 2790

PRODUCTION

1st 24 hrs. Nat. _____

1st 24 hrs. after shot _____

Gas _____ Cu. Ft.

Dry Hole _____

Abandoned _____

Date

AUG 23 1939 19S. J. LEWIS

Scout