

15149006100000

FORM 51 25M 8-50 WESTERN

Pottawatomie

KANSAS

Section 33 Township 6 Range 9 EWell No. # 1 ShearerCompany Malzahn

NORTH

				0			

WEST

EAST

SOUTH

2

Pottawatomie **KANSAS**

Sec. 33 Twp. 6 R. 9E

Well No. #1 Shearer Farm

Malzahn Company

Contractor

Wildcat


330' Ft. from N. Line

 Ft. from S. Line

 Ft. from E. Line

330' Ft. from W. Line

NW NW NE

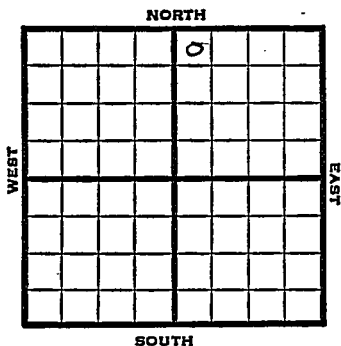

1951

Elev. -

REPORT

3/28

Location

5/29

Spd 4-17-51

8" @ 97'

TD 1915

D&A

ABANDONED

J. E. TYRA

County Pottawatomie State KansasSec. 33 (Blk.
Twp.) 6 (Sur.
Rge.) 9E Map No.Operator MalzahnWell No. 1 Farm ShearerElev. Location NW NW NE

330 Ft. From N Line NE330 Ft. From W Line Quarter

1st. Report

Completion MAY 9 1951Remarks WildcatSpudding Date 4-17-51

Drlg. Data

8" @ 97 TD 1915 D & A

J. E. TYRA