

STATE CORPORATION COMMISSION OF KANSAS
OIL & GAS CONSERVATION DIVISION
WELL COMPLETION OR RECOMPLETION FORM
ACO-1 WELL HISTORY
DESCRIPTION OF WELL AND LEASE

API NO. 15-087-20,437

26-7-185

Operator: License # 4068
Name Nat. Growth Min. & Res., Inc.
Address 3525 Diane Place
City/State/Zip Greeley, CO 80631

Purchaser N/A

Operator Contact Person Roy E. Friesen
Phone (303) 352-5043

Contractor: License # 5786
Name McGown Drilling Inc.

Wellsite Geologist Dean C. Schaafe
Phone (316) 733-5944

Designate Type of Completion N/A - D/A
☒ New Well ☐ Re-Entry ☐ Workover

Oil ☐ SWD ☐ Temp Abd
Gas ☐ Inj ☐ Delayed Comp.
☒ Dry ☐ Other (Core, Water Supply etc.)

If OMNO: old well info as follows:
Operator N/A
Well Name
Comp. Date Old Total Depth

WELL HISTORY

Drilling Method:
☒ Mud Rotary ☐ Air Rotary ☐ Cable
12/16/88 12/21/88 N/A 12-21-88
Spud Date Date Reached TD Completion Date
1820'
Total Depth PBDT

Amount of Surface Pipe Set and Cemented at 278 feet
Multiple Stage Cementing Collar Used? Yes ☒ No
If yes, show depth set feet
If alternate 2 completion, cement circulated from 0 feet depth to 278 w/ 63.5X cmt 62.5X PozmixA & Gel
Cement Company Name Halliburton Services
Invoice # 745493

County Jefferson
C. W/2 SW/4 Sec 26.. Twp 7... Rge 18.. ☒ East ☐ West
1320 Ft North from Southeast Corner of Section
4330 Ft West from Southeast Corner of Section
(Note: Locate well in section plat below)


Lease Name Moser Well # 1

Field Name Nortonville area

Producing Formation N/A

Elevation: Ground 1029' KB n/a

Section Plat

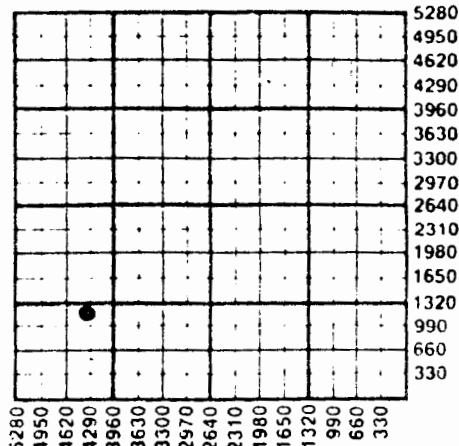

WATER SUPPLY INFORMATION

Disposition of Produced Water: ☐ Disposal
Docket # N/A ☐ Repressuring

Questions on this portion of the ACO-1 call:

Water Resources Board (913) 296-3717

Source of Water:
Division of Water Resources Permit #

Groundwater.....Ft North from Southeast Corner
(Well) Ft West from Southeast Corner of
Sec Twp Rge East West

☒ Surface Water 5100 Ft North from Southeast Corner
(Stream, pond, etc.) 2800 Ft West from Southeast Corner
Sec 36 Twp 7 Rge 18 ☒ East ☐ West
62.5X PozmixA & Gel
Other (explain)
(purchased from city, R.W.D. #)

INSTRUCTIONS: This form shall be completed in triplicate and filed with the Kansas Corporation Commission, 200 Colorado Derby Building, Wichita, Kansas 67202, within 120 days of the spud date of any well. Rule 82-3-130, 82-3-107 and 82-3-106 apply.
Information on side two of this form will be held confidential for a period of 12 months if requested in writing and submitted with the form. See rule 82-3-107 for confidentiality in excess of 12 months.
One copy of all wireline logs and drillers time log shall be attached with this form. Submit CP-4 form with all plugged wells. Submit CP-111 form with all temporarily abandoned wells.

All requirements of the statutes, rules and regulations promulgated to regulate the oil and gas industry have been fully complied with and the statements herein are complete and correct to the best of my knowledge.

Signature Roy E. Friesen Operator
Owner/Operator Date 1/6/89

Subscribed and sworn to before me this 6th day of January 1989
Notary Public Anne Wood
My Commission Expires March 30, 1992

K.C.C. OFFICE USE ONLY
☒ Letter of Confidentiality Attached
☒ Wireline Log Received
☐ Drillers Timelog Received
Distribution
☒ KCC ☐ SWD/Rep ☐ NGPA
☒ KGS ☐ Plug ☐ Other
(Specify)

JAN 12 1989

KANSAS GEOLOGICAL SURVEY
WICHITA BRANCH