


Section 14 Township 8 Range 11-E

Well No. #1 Mac Farland

Company Anderson-Prichard
Wildcat

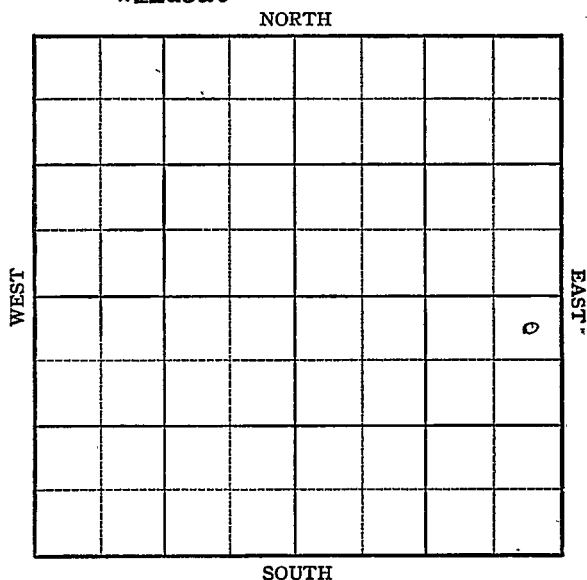

Sec. 14 Twp. 8 R. 11E

Well No. #1 MacFarland Farm

Anderson-Prichard Company

Pabco Contractor

Wildcat


330' Ft. from N. Line

 Ft. from S. Line

330' Ft. from E. Line

 Ft. from W. Line

NE SE

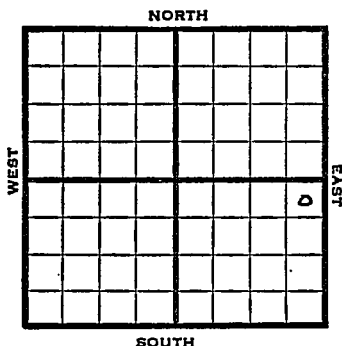

1949 Elev 1292' REPORT

11/9 8" @ 176'
Topeka 840'
Drlg. 1012'

11/16 Miss 2487'
Hunt 2718'
Drlg. 2932'

11/23 TD 3495'
Viola 3273'
Simpson 3399'
Granite 3486'
Aband.

$$\begin{array}{r} 2487 \\ 840 \\ \hline 1647 \end{array}$$

$$\begin{array}{r} 1292 \\ 840 \\ \hline +452 \end{array}$$

ABANDONED

Map No. _____ Sec. 14 Twp. 8 R. 11E

Well No. 1 Mac Farland

Anderson-Prichard Company

Pabco Contractor

NE SE

**FIRST REPORT
SECTION PLAT**

330 Ft. from N. Line

_____ Ft. from S. Line

330 Ft. from E. Line

_____ Ft. from W. Line

Pottawotomie County

Location _____

Rig up _____

Drilling and Remarks:

8" @ 176

Topeka 840

drlg. 1012

RECORD

Cased _____ in., _____ ft.

Sand _____

Gas _____

Oil _____

Total Depth _____

PRODUCTION

1st 24 hrs. Nat. _____

1st 24 hrs. after shot _____

Gas _____ Cu. Ft.

Dry Hole _____

Abandoned _____

Date

NOV 9 1949 19

S. J. LEWIS Scout

Kansas

Map No. _____ Sec. 14 Twp. 8 R. 11EWell No. 1 MacFarlandAnderson-Prichard

Company

ABANDONED

Contractor

NE SE

E 11292
SECTION PLAT330 Ft. from N. Line

_____ Ft. from S. Line

330 Ft. from E. Line

_____ Ft. from W. Line

			o

Pottawatomie County

Location _____

Rig up _____

Drilling and Remarks:

Wells 3273Orin 3399Granite 3486

RECORD

Cased _____ in., _____ ft.

Sand _____

Gas _____

Oil _____

Total Depth 377.5

PRODUCTION

1st 24 hrs. Nat. _____

1st 24 hrs. after shot _____

Gas _____ Cu. Ft.

Dry Hole _____

Abandoned _____

Date

NOV 23 1949

19

S. J. LEWIS

Scout