


14-8-15E

WELL LOG BUREAU—KANSAS GEOLOGICAL SOCIETY
508 East Murdock, Wichita, Kansas

Company- FRED B. ANSCHUTZ
Farm- Zule No. 1

SEC. 14 T. 8 R. 15E
NW NW NW

Total Depth. 2587'
Comm. 12-2-64 Comp. 12-11-64
Shot or Treated.
Contractor. Fred B. Anschutz
Issued. 1-9-65

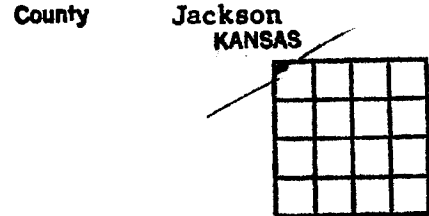

Elevation. 1125' DF

CASING:
8 5/8" 95.88' cem w/ 105 sx

Production. DRT

Figures Indicate Bottom of Formations.

shale, sand & shells	32	
shale & shells	980	
shale, lime & sand	1145	
shale & shells	1438	
shale	1658	
shale & sand	2179	
Mississippi	2302	
Mississippi lime	2324	
shale	2535	
lime & shale	2585	RTD
Total Depth		

TOPS: SCOUT

Lansing	982
Base Kansas City	1324
Mississippi	2182
Kinderhook	2326
Hunton	2536