

24-8-19E



SIDE ONE

STATE CORPORATION COMMISSION OF KANSAS
OIL & GAS CONSERVATION DIVISION
WELL COMPLETION OR RECOMPLETION FORM
ACO-1 WELL HISTORY
DESCRIPTION OF WELL AND LEASE

Operator: License # 5115
Name REESE EXPLORATION, INC
Address 5540 Raytown Rd
City/State/Zip Raytown, MO 64133

Purchaser Vanguard Pipeline
Houston, TX

Operator Contact Person Patricia Eichman
Phone 816/356-1970

Contractor: License # 5661
Name Kelly Down Drilling

Wellsite Geologist None
Phone

Designate Type of Completion

New Well Re-Entry Workover
 Oil SWD Temp Abd
 Gas Inj Delayed Comp.
 Dry Other (Core, Water Supply etc.)

If **OWO**: old well info as follows:
Operator
Well Name
Comp. Date Old Total Depth

WELL HISTORY


Drilling Method:
 Mud Rotary Air Rotary Cable
..7-6-87.. ..7-8-87.. ..7-9-87.....
Spud Date Date Reached TD Completion Date
...1736... ..1735.....
Total Depth PBTD

Amount of Surface Pipe Set and Cemented at 50 feet
Multiple Stage Cementing Collar Used? Yes No
If yes, show depth set.....feet.
If alternate 2 completion, cement circulated
from surf 50 feet depth to 10 w/ 10 SX cmt
Cement Company Name Company Tools

Estimated Production Per 24 Hours	Oil	250	MCF	Bbls	CFPB
					Production Interval

API NO. 15-...087-20.389
County...Jefferson
SE SW NE Sec. 24 Twp. 8 Rge. 19E XX East
2970 Ft North from Southeast Corner of Section
1500 Ft West from Southeast Corner of Section
(Note: Locate well in section plat below)
Lease Name. ROBERT DOMANN Well # 1-87..
Field Name...Winchester
Producing Formation...Cherokee Gas Sand
Elevation: Ground...Unk KB

Section Plat

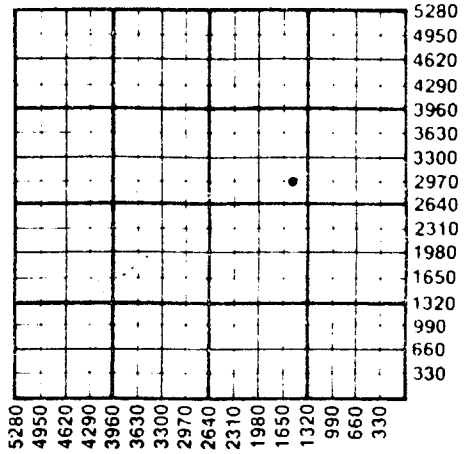

WATER SUPPLY INFORMATION

Disposition of Produced Water: Disposal
Docket # Repressuring

Questions on this portion of the ACO-1 call:

Water Resources Board (913) 296-3717
Source of Water:
Division of Water Resources Permit #.....
 Groundwater.....Ft North from Southeast Corner
(Well)Ft West from Southeast Corner of
Sec Twp Rge East West
 Surface Water.....Ft North from Southeast Corner
(Stream, pond etc).....Ft West from Southeast Corner
Sec Twp Rge East West

Other (explain) Purch. from the City of North
Gas Water Gas-Oil Ratio Gravity

Disposition of gas: Vented Sold
 Open Hole Perforation
 Other (Specify) 1654 - 1664

24-8-19E

SIDE TWO

Operator Name REESE EXPLORATION, INC. Lease Name ROBERT DOMANN Well # 1-87

Sec. 24 Twp. 8 Rge. 19E East West County Jefferson

WELL LOG

INSTRUCTIONS: Show important tops and base of formations penetrated. Detail all cores. Report all drill stem tests giving interval tested, time tool open and closed, flowing and shut-in pressures, whether shut-in pressure reached static level, hydrostatic pressures, bottom hole temperature, fluid recovery, and flow rates if gas to surface during test. Attach extra sheet if more space is needed. Attach copy of log.

Drill Stem Tests Taken Yes No
 Samples Sent to Geological Survey Yes No
 Cores Taken Yes No

Formation Description
 Log Sample

Name	Top	Bottom
Soil & Clay	0	10
Shale	10	28
Lime	28	42
Shale & Lime	42	859
Lime	859	920
Shale	920	1050
Lime & Shale	1050	1653
Sand	1653	1670
Lime	1670	1684
Sand	1684	1706
Mississippi Lime	1706	1736
Total Depth		1736

CASING RECORD New Used
 Report all strings set-conductor, surface, intermediate, production, etc.

Purpose of String	Size Hole Drilled	Size Casing Set (in O.D.)	Weight Lbs/Ft.	Setting Depth	Type of Cement	#Sacks Used	Type and Percent Additives
surface	8-3/4	7"		50	port.	10	none
casing	6 1/2	4 1/2		1735		149	2% Gel

PERFORATION RECORD Acid, Fracture, Shot, Cement Squeeze Record (Amount and Kind of Material Used) Depth

Shots Per Foot	Specify Footage of Each Interval Perforated	Depth
2	1654 - 1664	Natural Comp.

TUBING RECORD Size Set At Packer at Liner Run Yes No

Date of First Production Shut-in Producing Method Flowing Pumping Gas Lift Other (explain)