

24-8-196 ✓

STATE CORPORATION COMMISSION OF KANSAS
OIL & GAS CONSERVATION DIVISION
WELL COMPLETION OR RECOMPLETION FORM
ACO-1 WELL HISTORY
DESCRIPTION OF WELL AND LEASE

Operator: License # 5407
Name Hupfer Oil & Gas
Address 3711 Country Lane
City/State/Zip Hays, KS 67601

Purchaser.....

Operator Contact Person Dennis D. Hupfer
Phone 913-628-8666

Contractor: License # 4423
Name Van Drlg. Inc.

Wellsite Geologist George Peterson
Phone 913-272-4383

Designate Type of Completion

New Well Re-Entry Workover
 Oil SWD Temp Abd
 Gas Inj Delayed Comp.
 Dry Other (Core, Water Supply etc.)

If ONWO: old well info as follows:

Operator
Well Name
Comp. Date Old Total Depth.....

WELL HISTORY

Drilling Method:

Mud Rotary Air Rotary Cable

5-30-87 6-3-87 6-3-87
Spud Date Date Reached TD Completion Date

1780

Total Depth PBSD

JUL 27 1987 **KANSAS GEOLOGICAL SURVEY**
WICHITA BRANCH

Amount of Surface Pipe Set and Cemented 2 feet
Multiple Stage Cementing Collar Used? Yes No

If yes, show depth set.....feet

If alternate 2 completion, cement circulated
from 42 feet depth to surface 20 feet

Cement Company Name Van Drlg. (rig)

Invoice #

API NO. 15-..... 087-20,386

County..... Jefferson

C... NE.. NW.. Sec. 24 Twp. 8 Rge. 19

4620.... Ft North from Southeast Corner of Section
3300.... Ft West from Southeast Corner of Section
(Note: Locate well in section plat below)


Lease Name..... Dill Well #. A-1....

Field Name..... Winchester

Producing Formation.....

Elevation: Ground..... 1151 KB..... 1156

Section Plat

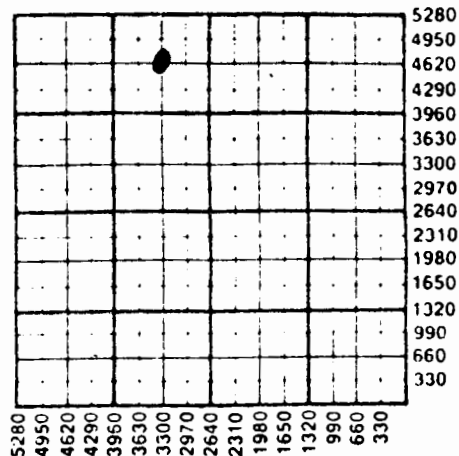

X

WATER SUPPLY INFORMATION

Disposition of Produced Water: Disposal
Docket # Repressuring

Questions on this portion of the ACO-1 call:

Water Resources Board (913) 296-3717

Source of Water:
Division of Water Resources Permit #.....

Groundwater.....Ft North from Southeast Corner
(Well)Ft West from Southeast Corner of
Sec Twp Rge East West

Surface Water..... 5280 Ft North from Southeast Corner
(Stream, pond etc)..... 2640 Ft West from Southeast Corner
NW/4 Sec 24 Twp 8 Rge 19 East West

Other (explain).....
(purchased from city, R.W.D. #)

INSTRUCTIONS: This form shall be completed in triplicate and filed with the Kansas Corporation Commission, 200 Colorado Derby Building, Wichita, Kansas 67202, within 120 days of the spud date of any well. Rule 82-3-130, 82-3-107 and 82-3-106 apply. Information on slide two of this form will be held confidential for a period of 12 months if requested in writing and submitted with the form. See rule 82-3-107 for confidentiality in excess of 12 months. One copy of all wireline logs and drillers time log shall be attached with this form. Submit CP-4 form with all plugged wells. Submit CP-111 form with all temporarily abandoned wells.

54-8-45

SIDE TWO

Operator Name Hupfer Oil & Gas Lease Name Dill Well # A-1

Sec. 24 Twp. 8 Rge. 19 East West County Jefferson

WELL LOG

INSTRUCTIONS: Show important tops and base of formations penetrated. Detail all cores. Report all drill stem tests giving interval tested, time tool open and closed, flowing and shut-in pressures, whether shut-in pressure reached static level, hydrostatic pressures, bottom hole temperature, fluid recovery, and flow rates if gas to surface during test. Attach extra sheet if more space is needed. Attach copy of log.

Drill Stem Tests Taken [] Yes [X] No
Samples Sent to Geological Survey [] Yes [X] No
Cores Taken [] Yes [X] No

Formation Description [X] Log [] Sample

Table with 3 columns: Name, Top, Bottom. Rows include Bace K.C., McLouth Sand, Mississippi, T.D.

D&A

CASING RECORD, PERFORATION RECORD, TUBING RECORD, Date of First Production, Producing Method