

24-8-196

SIDE ONE

STATE CORPORATION COMMISSION OF KANSAS
OIL & GAS CONSERVATION DIVISION
WELL COMPLETION OR RECOMPLETION FORM
ACO-1 WELL HISTORY
DESCRIPTION OF WELL AND LEASE

Operator: License # 5115
Name REESE EXPLORATION, INC.
Address 5540 Raytown Rd.
Raytown, MO 64133
City/State/Zip

Purchaser Vanguard Pipeline Corp.
Houston, TX

Operator Contact Person Patty Eichman
Phone 816-356-1970

Contractor: License # 5661
Name Kelly Down Drilling

Wellsite Geologist None
Phone

Designate Type of Completion

New Well Re-Entry Workover

Oil SWD Temp Abd
 Gas Inj Delayed Comp.
 Other (Core, Water Supply etc.)

If OWWO: old well info as follows:

Operator
Well Name
Comp. Date Old Total Depth

WELL HISTORY

Drilling Method:

Mud Rotary Air Rotary Cable

2/25/87 3/2/87 3/5/87
Spud Date Date Reached TD Completion Date

1735 N/A
Total Depth PBTD

Amount of Surface Pipe Set and Cemented at 42 feet
Multiple Stage Cementing Collar Used? Yes No
If yes, show depth set feet
If alternate 2 completion, cement circulated
from surf feet depth to 15 cmt
Cement Company Name Consolidated
Invoice # 72985

API NO. 15-087-20-363

County JEFFERSON

C SW SW Sec 24 Twp 8 Rge 19 East West

660 Ft North from Southeast Corner of Section
4620 Ft West from Southeast Corner of Section

(Note: Locate well in section plat below)


Lease Name H-Wistuba Well # 1-87

Field Name Unknown

Producing Formation N/A

Elevation: Ground KB

Section Plat

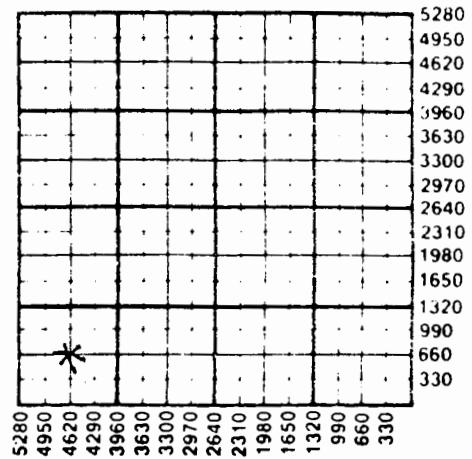

WATER SUPPLY INFORMATION

Disposition of Produced Water: Disposal
Docket # Repressuring

Questions on this portion of the ACO-1 call:

Water Resources Board (913) 296-3717

Source of Water:
Division of Water Resources Permit #

Groundwater Ft North from Southeast Corner
(Well) Ft West from Southeast Corner of
Sec Twp Rge East West

Surface Water Ft North from Southeast Corner
(Stream, pond etc) Ft West from Southeast Corner
Sec Twp Rge East West

Other (explain) purchased from city of McLouth
(purchased from city, R.W.D. #)

INSTRUCTIONS: This form shall be completed in triplicate and filed with the Kansas Corporation Commission, 200 Colorado Derby Building, Wichita, Kansas 67202, within 120 days of the spud date of any well. Rule 82-3-130, 82-3-107 and 82-3-106 apply. Information on side two of this form will be held confidential for a period of 12 months if requested in writing and submitted with the form. See rule 82-3-107 for confidentiality in excess of 12 months. One copy of all wireline logs and drillers time log shall be attached with this form. Submit CP-4 form with all plugged wells. Submit CP-111 form with all temporarily abandoned wells.

SIDE TWO

Operator Name REESE EXPLORATION Lease Name H. Wistuba Well # 1-87

Sec. 24 Twp. 8 Rge. 19 East West County JEFFERSON

WELL LOG

INSTRUCTIONS: Show important tops and base of formations penetrated. Detail all cores. Report all drill stem tests giving interval tested, time tool open and closed, flowing and shut-in pressures, whether shut-in pressure reached static level, hydrostatic pressures, bottom hole temperature, fluid recovery, and flow rates if gas to surface during test. Attach extra sheet if more space is needed. Attach copy of log.

Drill Stem Tests Taken Yes No
 Samples Sent to Geological Survey Yes No
 Cores Taken Yes No

Formation Description
 Log Sample

Name	Top	Bottom
Soil & clay	0	37
Shale	37	42
Lime	42	243
Shale & Lime	243	930
Lime	930	944
Big shale	944	1078
Lime & shale	1078	1448
Sand no show	1448	1458
Lime	1458	1523
Shale	1523	1711
Mississippi Line	1711	1735
Total depth		1735

CASING RECORD New Used
 Report all strings set-conductor, surface, intermediate, production, etc.

Purpose of String	Size Hole Drilled	Size Casing Set (in O.D.)	Weight Lbs/Ft.	Setting Depth	Type of Cement	#Sacks Used	Type and Percent Additives
Surface casing	6 1/4	7" / A/A		42'	part	15	none

PERFORATION RECORD		Acid, Fracture, Shot, Cement Squeeze Record	
Shots Per Foot	Specify Footage of Each Interval Perforated	(Amount and Kind of Material Used)	Depth

TUBING RECORD Size Set At Packer at Liner Run Yes No

Date of First Production 7-2-54 Producing Method Flowing Pumping Gas Lift Other, (explain).....