

KANSAS

Jefferson


15087000180000

FORM 51 5M 4-41 PETROL

Section 2 Township 8 Range 18-E

Well No. #1 Gillen

Company McLaughlin et al

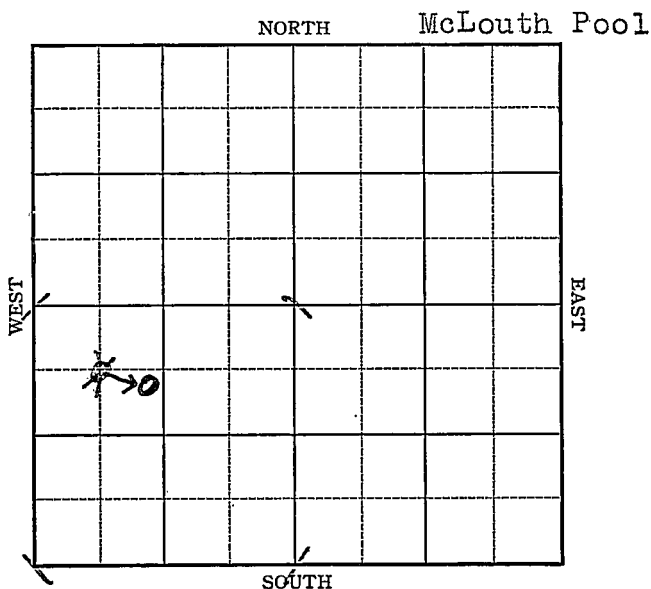

KANSAS

Jefferson

Sec. 2 Twp. 8 R. 18-E

Well No. #1 Gillen Farm

McLaughlin et al Company
(McLouth)


~~860~~ Ft. from N. Line

1750 Ft. from S. Line

 Ft. from E. Line

1210
~~860~~ Ft. from W. Line

Elev 1046

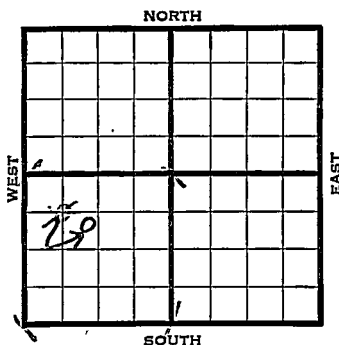

1942	REPORT
6/3	Location
6/10	Drlg. 392'
6/17	10" - 525' 8" - 1047' Drlg.
6/24	Miss. 1724'
	T.D. 1770'
	No shows.
	ABANDONED


Jefferson KANSAS

Map No. MM Sec. 2 Twp. 8 R. 18EWell No. 1 GillenMcLaughlin et al. CompanyFIRST REPORT Contractor

C NW SW

660 Ft. from N. Line Ft. from S. Line Ft. from E. Line660 Ft. from W. Line

SECTION PLAT

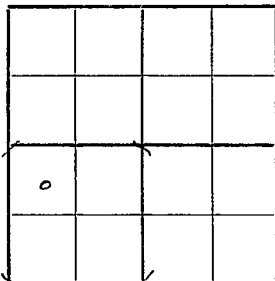MCLOUTH POOLLocation XXRig up

Drilling and Remarks:

RECORD

Cased in., ft.Sand Gas Oil Total Depth

PRODUCTION

1st 24 hrs. Nat. 1st 24 hrs. after shot Gas Cu. Ft.Dry Hole Abandoned

Date

JUN 3 1942 19S. J. LEWIS Scout

Jefferson **KANSAS**Map No. 4411 Sec. 2 Twp. 8 R. 18EWell No. 1 GillenMcLaughlin etal. CompanyCORRECTION ContractorC S $\frac{1}{2}$ N $\frac{1}{2}$ SW Ft. from N. Line1750 Ft. from S. Line Ft. from E. Line1210 Ft. from W. Line

SECTION PLAT

MCLOUTH POOLLocation Rig up

Drilling and Remarks:

Reported

C NW SW

RECORD

Cased in., ft.Sand Gas Oil Total Depth

PRODUCTION

1st 24 hrs. Nat. 1st 24 hrs. after shot Gas Cu. Ft.Dry Hole Abandoned

Date

JUN 10 1942 19S. J. LEWIS Scout

Map No. MM Sec. 2 Twp. 8 R. 18E

Well No. 1 Gillen

McLaughlin et al. Company

ABANDONED

Contractor

C $S\frac{1}{2}$ N $\frac{1}{2}$ SW

SECTION PLAT

 Ft. from N. Line

1750 Ft. from S. Line

 Ft. from E. Line

1210 Ft. from W. Line

MCLOUTH POOL

RECORD

Location

Cased in., ft.

Rig up

Sand

Drilling and Remarks:

Gas

Oil

Total Depth 1770

PRODUCTION

1st 24 hrs. Nat.

1st 24 hrs. after shot

Gas Cu. Ft.

Dry Hole

Abandoned

Date

JUN 24 1942

19

S. J. LEWIS

Scout