

34-8-216

SIDE ONE

STATE CORPORATION COMMISSION OF KANSAS
OIL & GAS CONSERVATION DIVISION
WELL COMPLETION OR RECOMPLETION FORM
ACO-1 WELL HISTORY
DESCRIPTION OF WELL AND LEASE

Operator: License # 9851
Name Pryor Oil Co.
Address 473 N. Shore Dr.
City/State/Zip Parkville MO 64151
Purchaser Kelly, McClasky
Operator Contact Person J. Pryor
Phone 816-587-1225

Contractor: License # 4968
Name Northeast Oil & Gas

Wellsite Geologist
Phone

Designate Type of Completion
 New Well Re-Entry Workover
 Oil SWD Temp
 Gas Inj Delayed Comp
 Dry Other (Core, Water Supply etc.)

If OWNO: old well info as follows:
Operator
Well Name
Comp. Date Old Total Depth

WELL HISTORY

Drilling Method:
 Mud Rotary Air Rotary Cable
9/26/88 9/30/88 10/13/88
Spud Date Date Reached TD Completion Date
1545' 1516'
Total Depth PBD

Amount of Surface Pipe Set and Cemented at 47 feet
Multiple Stage Cementing Collar Used? Yes No
If yes, show depth set feet
If alternate 2 completion, cement circulated from 1527 feet depth to surface 165 SX cmt
Cement Company Name Consolidated
Invoice # 96669

API NO. 15-103-21-053
County Leavenworth
NW SW NW Sec 34 Twp 8 Rge 21 East West

3630 Ft North from Southeast Corner of Section
4740 Ft West from Southeast Corner of Section
(Note: Locate well in section plat below)


Lease Name Bergman Well # 3
Field Name
Producing Formation McLouth

Elevation: Ground 1098.7' KB
Section Plat

DEC 06 1988

KANSAS GEOLOGICAL SURVEY
WICHITA BRANCH

RECEIVED
NOV 14 1988
STATE CORPORATION COMMISSION
CONSERVATION DIVISION
Wichita, Kansas

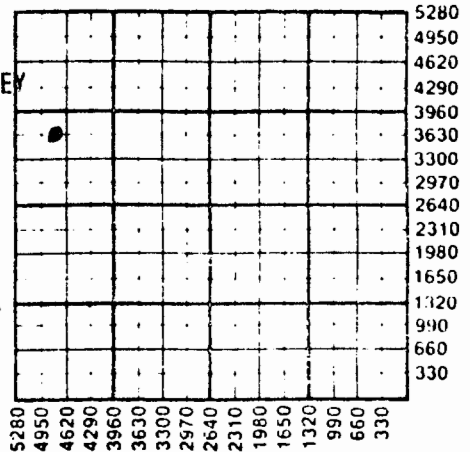

WATER SUPPLY INFORMATION

Disposition of Produced Water: Disposal
Docket # Repressuring

Questions on this portion of the ACO-1 call:

Water Resources Board (913) 296-3717

Source of Water:
Division of Water Resources Permit #

Groundwater Ft North from Southeast Corner (Well) Ft West from Southeast Corner
Sec Twp Rge East West

Surface Water Ft North from Southeast Corner (Stream, pond etc) Ft West from Southeast Corner
Sec Twp Rge East West

Other (explain) Purchased from Hawker (purchased from city, R.W.D. #)

INSTRUCTIONS: This form shall be completed in triplicate and filed with the Kansas Corporation Commission, 200 Colorado Derby Building, Wichita, Kansas 67202, within 120 days of the spud date of any well. Rule 82-3-130, 82-3-107 and 82-3-106 apply. Information on side two of this form will be held confidential for a period of 12 months if requested in writing and submitted with the form. See rule 82-3-107 for confidentiality in excess of 12 months. One copy of all wireline logs and drillers time log shall be attached with this form. Submit CP-4 form with all plugged wells. Submit CP-111 form with all temporarily abandoned wells.

All requirements of the statutes, rules and regulations promulgated to regulate the oil and gas industry have been fully complied with and the statements herein are complete and correct to the best of my knowledge.

Signature [Signature]
Title PRESIDENT Date 11-9-88

Subscribed and sworn to before me this 10th day of Nov 1988
Notary Public Dale A. Smith
Date Commission Expires 6/1/89

DALE A. SMITH
NOTARY PUBLIC
STATE OF KANSAS

My Appointment Expires 6/1/89

K.C.C. OFFICE USE ONLY
 Letter of Confidentiality Attached
 Wireline Log Received
 Drillers Time Log Received
Distribution
 KCC SWD/Rep NGPA
 KGS Plug Other (Specify)
CT

Sec 34 Twp 8 Rge 21 E