

1516100020000

Riley


KANSAS

FORM 51 5M 11-44 PETROL

Section 21 Township 8 Range 6-E

Well No. #1 Gravensteine

Company Ifemen et al

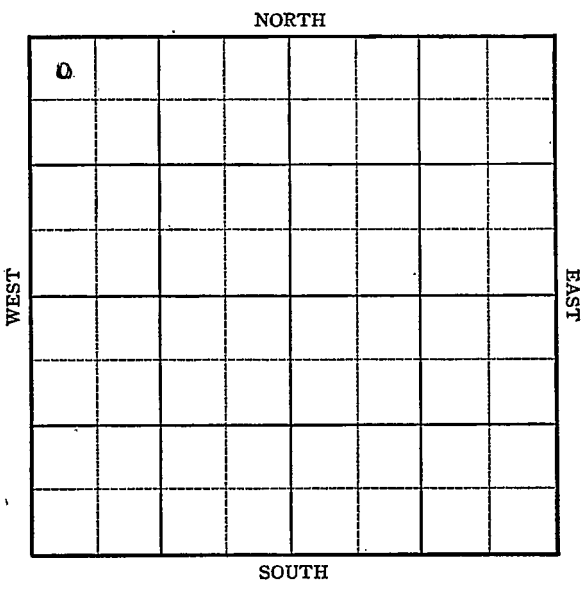


Sec. 21 Twp. 8 R. 6-E

Well No. #1 Gravensteine Farm

Ifeman et al Company

330 Ft. from N. Line  
 \_\_\_\_\_ Ft. from S. Line  
 \_\_\_\_\_ Ft. from E. Line  
330 Ft. from W. Line

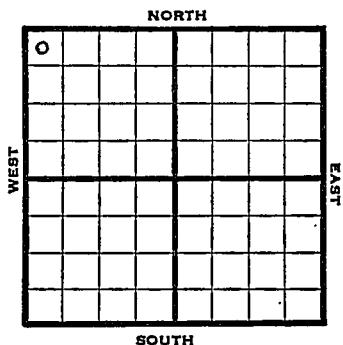

NW/c

1945 Elev. 1258 REPORT

12/12 RUR  
 12/20 8" - 120' Drlg. 1220'  
 12/29 Douglas 1290' Lans 1345'  
 K. C. 1410' Drlg. 1680'  
 1946 T Top +213  
 1/9 Douglas 1290 - 32 Doug - 32  
 Topeka 1045 + 213 Lan - 87  
 Lans 1345 - 87 KC - 128  
 KC 1386 - 90 Miss - 497  
 Miss. 1755 Viola. - 1267  
 Viola 2525 Granite Wash 2676  
 TD 2702' - Gw. - 1418  
 T.D. - 1444

ABANDONED

Top +213  
 Doug. - 32  
 Lans - 87  
 KC - 128  
 MISS - 497  
 T-m 710  
 L-m 410  
 KC-m 369

1386  
 1258  
 ---  
 128

1290  
 1258  
 ---  
 32

1258  
 1045  
 ---  
 213

1755  
 1258  
 ---  
 497

1345  
 1258  
 ---  
 87

497  
 128  
 ---  
 369

1755  
 1045  
 ---  
 710

410

KANSAS

Kansas

Pool Name WildcatMap No. 102 Sec. 21 Twp. 8 R. 6EWell No. 1 Gravensteine

Ifemam etal

Company

ABANDONED

Contractor

NW/c

E 1, 1258  
SECTION PLAT330 Ft. from N. Line

Ft. from S. Line

Ft. from E. Line

330 Ft. from W. Line

0			

Riley County

Location

Rig up

Drilling and Remarks:

*Topok 1045**Leans 1345**KC 1386**Miss 1753**Vidto 2525**Granite Wash 2676*

## RECORD

Cased \_\_\_\_\_ in., \_\_\_\_\_ ft.

Sand \_\_\_\_\_

Gas \_\_\_\_\_

Oil \_\_\_\_\_

Total Depth 2702

## PRODUCTION

.1st 24 hrs. Nat. \_\_\_\_\_

1st 24 hrs. after shot \_\_\_\_\_

Gas \_\_\_\_\_ Cu. Ft.

Dry Hole \_\_\_\_\_

Abandoned \_\_\_\_\_

Date

JAN 9 1946

19

S. J. LEWIS Scout

Kansas Pool Name Wildcat

Map No. K-102 Sec. 21 Twp. 8 R. 6E

Well No. L. Gravensteine

*MINING*

Ifemam etal Company

**FIRST REPORT**

Contractor

NW/c

**SECTION PLAT**

330 Ft. from N. Line

\_\_\_\_\_ Ft. from S. Line

\_\_\_\_\_ Ft. from E. Line

330 Ft. from W. Line

0			

Riley County

Location \_\_\_\_\_

Rig up \_\_\_\_\_

Drilling and Remarks:

RUR

**RECORD**

Cased \_\_\_\_\_ in., \_\_\_\_\_ ft.

Sand \_\_\_\_\_

Gas \_\_\_\_\_

Oil \_\_\_\_\_

Total Depth \_\_\_\_\_

**PRODUCTION**

1st 24 hrs. Nat. \_\_\_\_\_

1st 24 hrs. after shot \_\_\_\_\_

Gas \_\_\_\_\_ Cu. Ft.

Dry Hole \_\_\_\_\_

Abandoned \_\_\_\_\_

Date

DEC 1 2 1945 19

S. J. LEWIS

Score