

2-8-225



SIDE ONE

STATE CORPORATION COMMISSION OF KANSAS
OIL & GAS CONSERVATION DIVISION
WELL COMPLETION OR RECOMPLETION FORM
ACO-1 WELL HISTORY
DESCRIPTION OF WELL AND LEASE

Operator: License # 6871
Fairway Petroleum, Inc.
Name
Address 12603 Southwest Freeway
Suite 370
City/State/Zip Stafford, TX 77477

Purchaser N/A

Operator Contact Person Jeanne E. Flanagan
Phone (713) 240-1555

Contractor: License # 4160
Hutton Drilling
Name

Wellsite Geologist Larry E. Culbertson
Phone (913) 773-8514

Ignate Type of Completion
 New Well Re-Entry Workover
 Oil SWD Temp Abd
 Gas Inj Delayed Comp.
 Dry Other (Core, Water Supply etc.)
If OWMO: old well info as follows:

Operator
Well Name
Comp. Date

WELL HISTORY

Drilling Method:
 Mud Rotary Air Rotary Cable
9/10/87 9/12/87 9/12/87
Spud Date Date Reached TD Completion Date
1450
Total Depth PBD

Amount of Surface Pipe Set and Cemented at 43 feet
Multiple Stage Cementing Collar Used? Yes No
If yes, show depth set feet
If alternate 2 completion, cement circulated from feet depth to w/ SX cmt
Cement Company Name
Invoice #

API NO. 15-103-20,897

County Leavenworth

SE NW SW Sec 7 Twp 8 Rge 22 East West

1890 Ft North from Southeast Corner of Section
4370 Ft West from Southeast Corner of Section
(Note: Locate well in section plot below)


Lease Name Jenkins Well # 2

Field Name

Producing Formation

Elevation: Ground 1030 KB

Section Plot

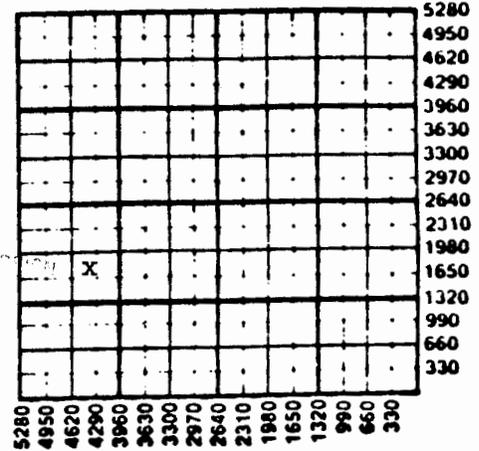

RECEIVED
NOV 16 1987
CONSERVATION DIVISION
Wichita, Kansas

WATER SUPPLY INFORMATION

Disposition of Produced Water: Disposal
Docket # Repressuring

Questions on this portion of the ACO-1 call:
Water Resources Board (913) 296-3717
Source of Water:
Division of Water Resources Permit #
 Groundwater.....Ft North from Southeast Corner (Well)Ft West from Southeast Corner of Sec Twp Rge East West
 Surface Water.....Ft North from Southeast Corner (Stream, pond etc).....Ft West from Southeast Corner Sec Twp Rge East West
 Other (explain) Purchased from local hauler (purchased from city, R.W.D. #)

INSTRUCTIONS: This form shall be completed in triplicate and filed with the Kansas Corporation Commission, 200 Colorado Derby Building, Wichita, Kansas 67202, within 120 days of the spud date of any well. Rule 82-3-130, 82-3-107 and 82-3-106 apply. Information on side two of this form will be held confidential for a period of 12 months if requested in writing and submitted with the form. See rule 82-3-107 for confidentiality in excess of 12 months. One copy of all wireline logs and drillers time log shall be attached with this form. Submit GP-4 form with temporarily abandoned wells.

Operator Name Fairway Petroleum, Inc. Lease Name Jenkins Well # 2

Sec. 7 Twp. 8S Rge. 22 East West County Leavenworth

WELL LOG

INSTRUCTIONS: Show important tops and base of formations penetrated. Detail all cores. Report all drill stem tests giving interval tested, time tool open and closed, flowing and shut-in pressures, whether shut-in pressure reached static level, hydrostatic pressures, bottom hole temperature, fluid recovery, and flow rates if gas to surface during test. Attach extra sheet if more space is needed. Attach copy of log.

Drill Stem Tests Taken Yes No
 Samples Sent to Geological Survey Yes No
 Cores Taken Yes No

Formation Description
 Log Sample

Name	Top	Bottom
Coal	1210	1211
Shale, sandy	1212	1258
Shale, light	1259	1267
Coal	1268	1269
Shale & sand	1270	1302
Coal	1303	1303
Sand & shale	1304	1313
Coal	1314	1314
Shale & sand	1315	1445
Lime	1445	1450
TD		1450

CASING RECORD New Used

Report all strings set-conductor, surface, intermediate, production, etc.

Purpose of String	Size Hole Drilled	Size Casing Set (In O.D.)	Weight Lbs/Ft.	Setting Depth	Type of Cement	#Sacks Used	Type and Percent Additives
surface	9 1/4	7"		43	Portland	16	

PERFORATION RECORD

Acid, Fracture, Shot, Cement Squeeze Record

Shots Per Foot	Specify Footage of Each Interval Perforated	(Amount and Kind of Material Used)	Depth

TUBING RECORD Size Set At Packer at Liner Run Yes No

Date of First Production N/A Producing Method Flowing Pumping Gas Lift Other (explain).....