18-8-22E

SIDE ONE

STATE CORPORATION COMMISSION OF KANSAS
OIL & GAS CONSERVATION DIVISION

WELL COMPLETION OR RECOMPLETION FORM
ACO-1 WELL HISTORY

API NO. 15- 103-20,481

County Leavenworth

NE NE SW Sec. 18 Twp 8 S Rge. 22 [X] East [ ] West

2310 Ft North from Southeast Corner of Section
2970 Ft West from Southeast Corner of Section
(Note: Locate well in section plat below)

Lease Name Hund Well # 8

Field Name

Producing Formation CHEROKEE SAND

Elevation: Ground 877' KB

DESCRIPTION OF WELL AND LEASE

Operator: License # 9803
Name Wykoma Oil, Inc.
Address P.O. Box 838
City/State/Zip Pine Bluffs, WY 82082

Purchaser LAGGS, HOUSTON, TEXAS
MACLASKEY, ELDORADO, KANSAS

Operator Contact Person Kenneth D. Spear
Phone 316-721-0572

Contractor: License # 5101
Name K & W Drilling

Wellsite Geologist Kenneth D. Spear
Phone 316-721-0572

Designate Type of Completion
[X] New Well [ ] Re-Entry [ ] Workover

[ ] Oil [ ] SWD [ ] Temp Abd
[ ] Gas [ ] Inj [ ] Delayed Comp.
[ ] Dry [ ] Other (Core, Water Supply etc.)

If OWWO: old well info as follows:
Operator
Well Name
Comp. Date Old Total Depth

Section Plat

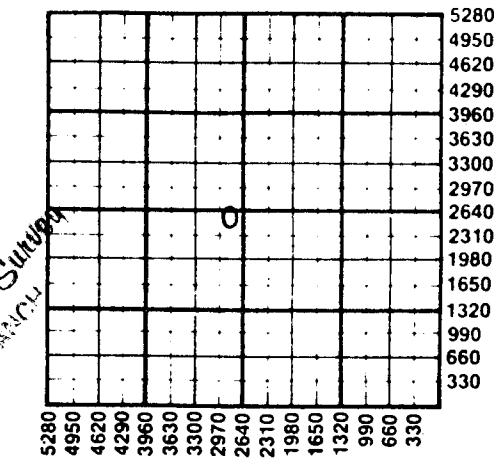

WATER SUPPLY INFORMATION
Disposition of Produced Water: [X] Disposal
Docket # [ ] Repressuring

WELL HISTORY

Drilling Method:
[X] Mud Rotary [ ] Air Rotary [ ] Cable

10-4-85	10-7-85	2-10-86
Spud Date	Date Reached TD	Completion Date

1315'	
Total Depth	PBTD

Amount of Surface Pipe Set and Cemented at 109' feet
Multiple Stage Cementing Collar Used? [ ] Yes [X] No
If yes, show depth set feet
If alternate 2 completion, cement circulated
from 1315 feet depth to surface w/ 150 SX cmt

Questions on this portion of the ACO-1 call:
Water Resources Board (913) 296-3717
Source of Water:
Division of Water Resources Permit #

[ ] Groundwater Ft North from Southeast Corner
(Well) Ft West from Southeast Corner of
Sec Twp Rge [ ] East [ ] West

[ ] Surface Water Ft North from Southeast Corner
(Stream, pond etc) Ft West from Southeast Corner
Sec Twp Rge [ ] East [ ] West

[ ] Other (explain)
(purchased from city, R.W.D. #)

INSTRUCTIONS: This form shall be completed in duplicate and filed with the Kansas Corporation Commission, 200 Colorado Derby Building, Wichita, Kansas 67202, within 90 days after completion or recompletion of any well. Rule 82-3-130 and 82-3-107 apply.
Information on side two of this form will be held confidential for a period of 12 months if requested in writing and submitted with the form. See rule 82-3-107 for confidentiality in excess of 12 months.
One copy of all wireline logs and drillers time log shall be attached with this form. Submit CP-4 form with all plugged wells. Submit CP-111 form with all temporarily abandoned wells.

RECEIVED
STATE CORPORATION COMMISSION
MAR 18 1986

MAR 18 1986
Geological Survey
Wichita, Branch