

8235
SIDE ONE

18-8-22 E

STATE CORPORATION COMMISSION OF KANSAS
OIL & GAS CONSERVATION DIVISION
WELL COMPLETION FORM
ACO-1 WELL HISTORY
DESCRIPTION OF WELL AND LEASE

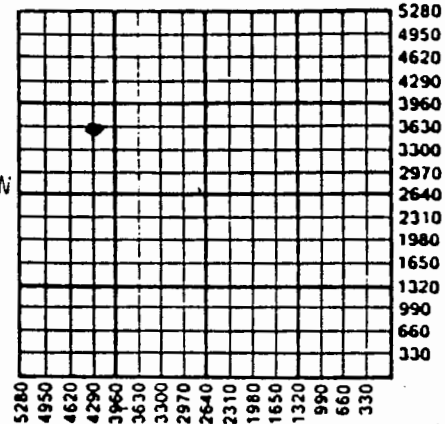
API NO. 15-

County

Leavenworth

Sec. 18 Twp 8 Rge. 22 East West

3630 Ft. North from Southeast Corner of Section

4290 Ft. West from Southeast Corner of Section
(NOTE: Locate well in section plat below.)Lease Name Hurd Well # 74 13 perField Name LeavenworthProducing Formation McClureElevation: Ground 937 KB 939Total Depth 1389 PBDTAmount of Surface Pipe Set and Cemented at 40 FeetMultiple Stage Cementing Collar Used? Yes ☒ NoIf yes, show depth set 40 FeetIf Alternate II completion, cement circulated from 40feet depth to Surface w/ 46 sx cmt.Operator: License # 03844Name: L & G EnergyAddress 2020 EvergreenSt. Collins ColoCity/State/Zip 80524Purchaser: McClureOperator Contact Person: B. CavePhone (816) 579 5940Contractor: Name: JamesLicense: JamesWellsite Geologist: R. Lomax

Designate Type of Completion

☒ New Well ☐ Re-Entry ☐ Workover☒ Oil ☐ SWD ☐ Temp. Abd.☒ Gas ☐ Inj ☐ Delayed Comp.☐ Dry ☐ Other (Core, Water Supply, etc.)

OWMO: old well info as follows:

Operator: _____

Well Name: _____

Comp. Date _____ Old Total Depth _____

Drilling Method: ☒ Mud Rotary ☐ Air Rotary ☐ CableSpud Date Feb 88 Date Reached TD Mar 88 Completion Date June 88

INSTRUCTIONS: This form shall be completed in triplicate and filed with the Kansas Corporation Commission, 200 Colorado Derby Building, Wichita, Kansas 67202, within 120 days of the spud date of any well. Rule 82-3-130, 82-3-107 and 82-3-106 apply. Information on side two of this form will be held confidential for a period of 12 months if requested in writing and submitted with the form. See rule 82-3-107 for confidentiality in excess of 12 months. One copy of all wireline logs and drillers time log shall be attached with this form. ALL CEMENTING TICKETS MUST BE ATTACHED. Submit CP-4 form with all plugged wells. Submit CP-111 form with all temporarily abandoned wells. Any recompletion, workover or conversion of a well requires filing of ACO-2 within 120 days from commencement date of such work.

All requirements of the statutes, rules and regulations promulgated to regulate the oil and gas industry have been fully complied with and the statements herein are complete and correct to the best of my knowledge.

Signature Shirley M. McClureTitle Pres. Date 9/05/89Subscribed and sworn to before me this 5 day of September, 19 89.Notary Public Kimberly A. SummitDate Commission Expires January 21, 1993

K.C.C. OFFICE USE ONLY

F ☐ Letter of Confidentiality Attached
C ☐ Wireline Log Received
C ☐ Drillers Timelog Received

Distribution

☒ KCC ☐ SWD/Rep ☐ NGPA
☒ KGS ☐ Plug ☒ Other (Specify) IS