

21-8-22E P1

STATE CORPORATION COMMISSION OF KANSAS
OIL & GAS CONSERVATION DIVISION
WELL COMPLETION OR RECOMPLETION FORM
ACO-1 WELL HISTORY

F

DESCRIPTION OF WELL AND LEASE

Operator: license # 9803
name Wykoma Oil, Inc.
address P.O. Box 838
City/State/Zip Pine Bluffs, WY 82082

Operator Contact Person Kenneth D. Spear
Phone 316-721-0572

Contractor: license # 5101
name K & W Drilling

Geologist Kenneth D. Spear
Phone 316-721-0572

PURCHASER

Designate Type of Completion
 New Well Re-Entry Workover

- Oil SWD Temp Abd
- Gas Inj Delayed Comp.
- Other (Core, Water Supply etc.)

If OWWO: old well info as follows:

Operator
Well Name
Comp. Date Old Total Depth

WELL HISTORY

Drilling Method: Mud Rotary Air Rotary Cable
6-9-85 6-13-85 none
Sp. Date Date Reached TD Completion Date
1320' none
Total Depth PBTD

If Surface Pipe Set and Cemented at 101' w/ 61 sks. feet

Multiple Stage Cementing Collar Used? Yes No

If Yes, Show Depth Set feet

If alternate 2 completion, cement circulated plugged well.
from feet depth to w/ SX cmt

API NO. 15- 103-20, 364
County Leavenworth
SW SE NE Sec. 21 Twp. 8S Rge. 22



2970 990 Ft North from Southeast Corner of Section
Ft West from Southeast Corner of Section
(Note: locate well in section plat below)


Lease Name W. Forge Well# 3

Field Name

Producing Formation NONE

Elevation: Ground 868 KB

Section Plat

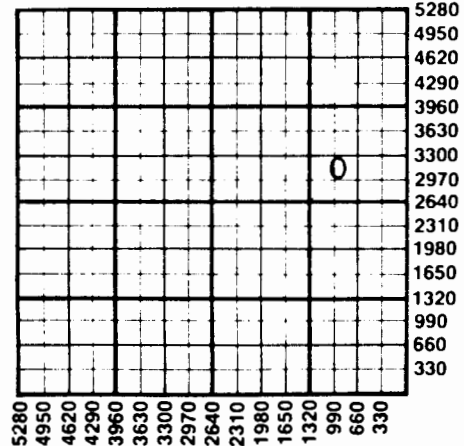

JUN 27 1985
State Geological Survey
WICHITA BRANCH

WATER SUPPLY INFORMATION

Source of Water:
Division of Water Resources Permit #

Groundwater Ft North From Southeast Corner of (Well) Ft. West From Southeast Corner
Sec Twp Rge East West

Surface Water 2999' Ft North From Southeast Corner of (Stream, Pond etc.) 700' Ft West From Southeast Corner
Sec 21 Twp 8S Rge 22 East West

Other (explain) (purchased from city, R.W.D.#)

Disposition of Produced Water: Disposal Repressuring
none

Docket #

INSTRUCTIONS: This form shall be completed in duplicate and filed with the Kansas Corporation Commission, 200 Colorado Derby Building Wichita, Kansas 67202, within 90 days after completion or recompletion of any well. Rules 82-3-130 and 82-3-107 apply.

Information on side two of this form will be held confidential for a period of 12 months if requested in writing and submitted with the form. See rule 82-3-10 for confidentiality in excess of 12 months.

One copy of all wireline logs and drillers time log shall be attached with this form. Submit CP-4 form with all plugged wells. Submit CP-111 form with all temporarily abandoned wells.