

29-8-22E

STATE CORPORATION COMMISSION OF KANSAS  
OIL & GAS CONSERVATION DIVISION  
WELL COMPLETION OR RECOMPLETION FORM  
ACO-1 WELL HISTORY  
DESCRIPTION OF WELL AND LEASE

Operator: License # 4081  
Name Simco Petroleum  
Address P.O. Box 1515  
City/State/Zip Cheyenne, WY 82003-1515

Purchaser Fautina

Operator Contact Person Kenneth D. Spear  
Phone 316-721-0572

Contractor: License # 5101  
Name K.W. Drilling

Wellsite Geologist Kenneth D. Spear  
Phone 316-721-0572

Designate Type of Completion  
 New Well     Re-Entry     Workover  
  
 Oil     SWD     Temp Abd  
 Gas     Inj     Delayed Comp.  
 Dry     Other (Core, Water Supply etc.)

If **OWWO**: old well info as follows:  
Operator .....  
Well Name .....  
Comp. Date ..... Old Total Depth.....

WELL HISTORY

Drilling Method:  
 Mud Rotary     Air Rotary     Cable  
  
3-11-86    3-14-86    3-21-86  
.....  
Spud Date    Date Reached TD    Completion Date

1446'  
.....  
Total Depth    PBD

Amount of Surface Pipe Set and Cemented at 147'  
Multiple Stage Cementing Collar Used?  Yes  No  
If yes, show depth set.....feet  
If alternate 2 completion, cement circulated  
from 1446' feet depth to surface 221' SX cmt  
Cement Company Name Consolidated  
Invoice # 65116

API NO. 15-103-20,526

County Leavenworth

SW NE NW Sec. 29 Twp. 8S Rge. 22



4290 Ft North from Southeast Corner of Section  
3630 Ft West from Southeast Corner of Section  
(Note: Locate well in section plat below)


Lease Name J. Heim Well # 3

Field Name.....

Producing Formation Cherokee Sand

Elevation: Ground 1010! KB.....

Section Plat

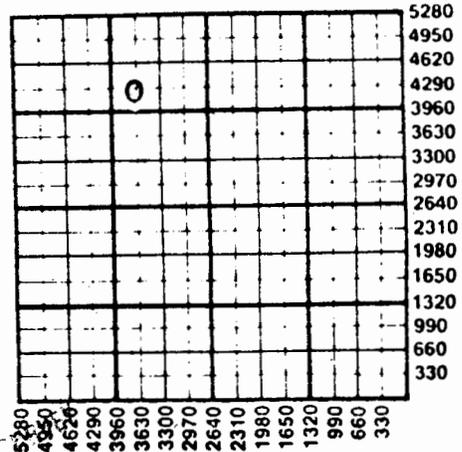

APR 28 1986

WATER SUPPLY INFORMATION

Disposition of Produced Water:  Disposal  
Docket # .....  Repressuring

Questions on this portion of the ACO-1 call:  
Water Resources Board (913) 296-3717

Source of Water:  
Division of Water Resources Permit #.....

Groundwater.....Ft North from Southeast Corner  
(Well) .....Ft West from Southeast Corner of  
Sec    Twp    Rge    East    West

Surface Water.....Ft North from Southeast Corner  
(Stream, pond etc).....Ft West from Southeast Corner  
Sec    Twp    Rge    East    West

Other (explain).....  
(purchased from city, R.W.D. #)

INSTRUCTIONS: This form shall be completed in duplicate and filed with the Kansas Corporation Commission, 200 Colorado Derby Building, Wichita, Kansas 67202, within 90 days after completion or recompletion of any well. Rule 82-3-130 and 82-3-107 apply.  
Information on side two of this form will be held confidential for a period of 12 months if requested in writing and submitted with the form. See rule 82-3-107 for confidentiality in excess of 12 months.  
One copy of all wireline logs and drillers time log shall be attached with this form. Submit CP-4 form with all plugged wells. Submit CP-111 form with...