

STATE CORPORATION COMMISSION OF KANSAS
OIL & GAS CONSERVATION DIVISION
WELL COMPLETION OR RECOMPLETION FORM
ACO-1 WELL HISTORY
DESCRIPTION OF WELL AND LEASE

103-20892



API NO. 15-.....
County Leavenworth
E/2 W/2 NW/4 30 8 22 X East
..... Sec..... Twp..... Rge..... West

Operator: License # 4081
Name Simco Petroleum Company
Address P.O. Box 1515
City/State/Zip Cheyenne, WY 82003

3960
4290 Ft North from Southeast Corner of Section
..... Ft West from Southeast Corner of Section
(Note: Locate well in section plat below)

Purchaser Oil- Inland Crude
Gas- Caporale

Lease Name C. Heim Well # 12

Operator Contact Person Ted Simola
Phone 307-632-6468

Field Name Slammer Northeast
Producing Formation "Stray" McLouth & Upper McLouth

Contractor: License # 5825
Name Glacier Drilling Company


Elevation: Ground 881 KB 886

Wellsite Geologist Daniel T. Johnson
Phone 316-221-6730

Designate Type of Completion
X New Well ___ Re-Entry ___ Workover
X Oil ___ SWD ___ Temp Abd
X Gas ___ Inj ___ Delayed Comp.
___ Dry ___ Other (Core, Water Supply etc.)

If ONWO: old well info as follows:
Operator
Well Name
Comp. Date Old Total Depth.....

Section Plat

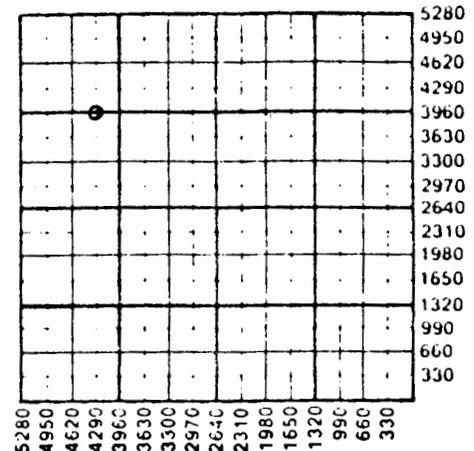

WATER SUPPLY INFORMATION

Disposition of Produced Water: NA Disposal
Docket # Repressuring

WELL HISTORY

Drilling Method:
X Mud Rotary ___ Air Rotary ___ Cable
8-11-87 8-13-87 11-15-87
Spud Date Date Reached TD Completion Date
1301 LTD 1300
Total Depth PBTD

Amount of Surface Pipe Set and Cemented at 71 feet
Multiple Stage Cementing Collar Used? Yes X No
If yes, show depth set NA feet
If alternate 2 completion, cement circulated
from 1300 feet depth to surface 1300 feet
Cement Company Name Sun Cmt & Acicizing Inc
Invoice # 1910

Questions on this portion of the ACO-1 call:

Water Resources Board (913) 296-3717

Source of Water:
Division of Water Resources Permit # NA

Groundwater.....Ft North from Southeast Corner
(Well)Ft West from Southeast Corner of
Sec Twp Rge East West

X Surface Water 4290 Ft North from Southeast Corner
(Stream, pond etc) 3630 Ft West from Southeast Corner
Sec 30 Twp 8 Rge 22 X East West

Other (explain).....
(purchased from city, R.W.D. #)

INSTRUCTIONS: This form shall be completed in triplicate and filed with the Kansas Corporation Commission, 200 Colorado Derby Building, Wichita, Kansas 67202, within 120 days of the spud date of any well. Rule 82-3-130, 82-3-107 and 82-3-106 apply. Information on side two of this form will be held confidential for a period of 12 months if requested in writing and submitted with the form. See rule 82-3-107 for confidentiality in excess of 12 months. One copy of all wireline logs and drillers time log shall be attached with this form. Submit CP-4 form with all plugged wells. Submit CP-111 form with all temporarily abandoned wells.