

STATE CORPORATION COMMISSION OF KANSAS
OIL & GAS CONSERVATION DIVISION

WELL COMPLETION OR RECOMPLETION FORM
ACO-1 WELL HISTORY

DESCRIPTION OF WELL AND LEASE

Operator: License # 8493
Name S & V Oil, Inc.
Address P.O. Box 857
City/State/Zip Russell, Ks 67665

Purchaser none

Operator Contact Person James H. Norris
Phone 913-483-4376

Contractor: License # 4423
Name Van Drilling, Inc.

Wellsite Geologist none
Phone

Designate Type of Completion

- New Well Re-Entry Workover
- Oil SWD Temp Abd
- Gas Inj Delayed Comp.
- Dry Other (Core, Water Supply etc.)

If OWO: old well info as follows:

Operator
Well Name
Comp. Date Old Total Depth

WELL HISTORY

Drilling Method:
 Mud Rotary Air Rotary Cable

5-2-86 5-4-86 n/c
Spud Date Date Reached TD Completion Date
1471
Total Depth PBTD

Amount of Surface Pipe Set and Cemented at 40 feet
Multiple Stage Cementing Collar Used? Yes No
If yes, show depth set feet
If alternate 2 completion, cement circulated from 40 feet depth to surface, 11.5X cmt

API NO. 15-103-20,620
County Leavenworth
NW NW SW Sec. 32 Twp. 8 Rge. 22 East West

2310 Ft North from Southeast Corner of Section
4950 Ft West from Southeast Corner of Section
(Note: Locate well in section plat below)


Lease Name Baumgartner "C" Well # 2

Field Name Sleepy Hollow

Producing Formation Burgess

Elevation: Ground 1046 KB

Section Plat

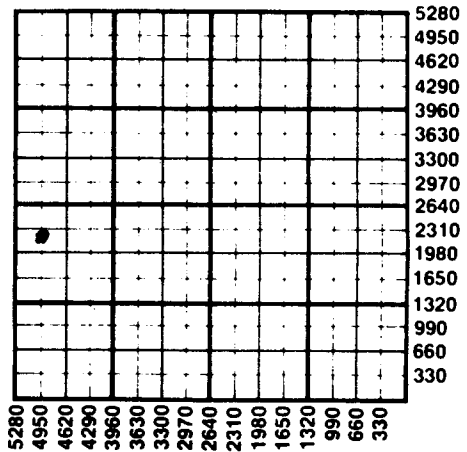

WATER SUPPLY INFORMATION

Disposition of Produced Water: Disposal Repressuring
Docket #

Questions on this portion of the ACO-1 call:

Water Resources Board (913) 296-3717

Source of Water:
Division of Water Resources Permit #

Groundwater.....Ft North from Southeast Corner (Well)Ft West from Southeast Corner of Sec Twp Rge East West

Surface Water.....Ft North from Southeast Corner (Stream, pond etc).....Ft West from Southeast Corner Sec Twp Rge East West

Other (explain)..... (purchased from city, R.W.D. #)

INSTRUCTIONS: This form shall be completed in duplicate and filed with the Kansas Corporation Commission, 200 Colorado Derby Building, Wichita, Kansas 67202, within 90 days after completion or recompletion of any well. Rule 82-3-130 and 82-3-107 apply.

Information on side two of this form will be held confidential for a period of 12 months if requested in writing and submitted with the form. See rule 82-3-107 for confidentiality in excess of 12 months. One copy of all wireline logs and drillers time log shall be attached with this form. Submit CP-4 form with all plugged wells. Submit CP-111 form with all temporarily abandoned wells.

All requirements of the statutes, rules and regulations promulgated to regulate the oil and gas industry have been fully complied with and the statements herein are complete and correct to the best of my knowledge.

25-8-58

SIDE TWO

Operator Name S & V Oil, Inc. Lease Name..... Baumgartner "C" Well #..... 2

Sec. 32 TWD. 8 Rge. 22 East West County. Leavenworth

<i>Not Comp.</i> Estimated Production Per 24 Hours	Oil	Gas	Water	Gas-Oil Ratio	Gravity
	0 Bbls	0 MCF	0 Bbls		

METHOD OF COMPLETION Production Interval

Disposition of gas: Vented Open Hole Perforation 1426-1430

Drill Stem Tests Taken Yes No
 Samples Sent to Geological Survey Yes No
 Cores Taken Yes No

Formation Description

Log Sample

Name	Top	Bottom
Lansing		
B. Kansas City	n/t	
Cherokee		
Coal Marker		
McLouth		
Upper Burgress		
Lower Burgress		
St. Louis		
Spergen		
Warsaw		
td		1471

CASING RECORD New Used
 Report all strings set-conductor, surface, intermediate, production, etc.

Purpose of String	Size Hole Drilled	Size Casing Set (In O.D.)	Weight Lbs/Ft.	Setting Depth	Type of Cement	#Sacks Used	Type and Percent Additives
surface	8 3/4	7	18	40	Portland	Common	60/40 poz
production	6 1/4	4.5	9.5	1470	Portland A	159	6% gel 6% salt

PERFORATION RECORD Acid, Fracture, Shot, Cement Squeeze Record
 (Amount and Kind of Material Used) Depth

Shots Per Foot	Specify Footage of Each Interval Perforated	Depth
3	1426-1430	250 gallons of 20% mud acid
		1426-1430

TUBING RECORD Size Set At Packer at Liner Run Yes No

Date of First Production Producing Method
 none Flowing Pumping Gas Lift Other (explain).....