

STATE CORPORATION COMMISSION OF KANSAS
OIL & GAS CONSERVATION DIVISION

WELL COMPLETION OR RECOMPLETION FORM
ACO-1 WELL HISTORY

DESCRIPTION OF WELL AND LEASE



Operator: License # 7982
Name Fred C. Berckefeldt
Address 1410 N 2nd Box 517
City/State/Zip Fredonia, Ks 66736

Purchaser Laggis-Leavenworth Joint Venture
Kc-Kcc

Operator Contact Person same
Phone

Contractor: License # same
Name

Wellsite Geologist none
Phone

Designate Type of Completion
 New Well Re-Entry Workover
 Oil SWD Temp Abd
 Gas Inj Delayed Comp.
 Dry Other (Core, Water Supply etc.)

If OWO: old well info as follows:
Operator
Well Name
Comp. Date Old Total Depth

WELL HISTORY

Drilling Method:
 Mud Rotary Air Rotary Cable
8/22/85 8/24/85 9/10/85
Spud Date Date Reached TD Completion Date
1441
Total Depth PBD


Amount of Surface Pipe Set and Cemented at 88 feet
Multiple Stage Cementing Collar Used? Yes No
if yes, show depth set feet
if alternate 2 completion, cement circulated from 88 feet depth to T.D. w/ 48 SX cmt

API NO. 15-103-20,402
County Leavenworth
C. W 1 SE SE Sec 33 Twp 8 Rge 22 East West

660 Ft North from Southeast Corner of Section
745 Ft West from Southeast Corner of Section
(Note: Locate well in section plat below)

Lease Name Burre Well # 2
Field Name Burre
Producing Formation Burgess

Elevation: Ground 1095.7 KB
Section Plat

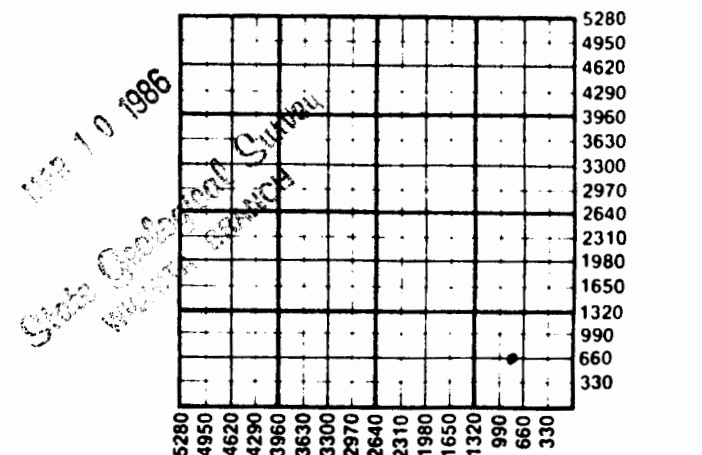

X WATER SUPPLY INFORMATION
Disposition of Produced Water: Disposal Repressuring
Docket #

Questions on this portion of the ACO-1 call:
Water Resources Board (913) 296-3717

Source of Water:
Division of Water Resources Permit # D.A.
 Groundwater.....Ft North from Southeast Corner (Well)Ft West from Southeast Corner of Sec Twp Rge East West
 Surface Water.....Ft North from Southeast Corner (Stream, pond etc).....Ft West from Southeast Corner Sec Twp Rge East West
 Other (explain) Salt water..... (purchased from city, R.W.D. #)

INSTRUCTIONS: This form shall be completed in duplicate and filed with the Kansas Corporation Commission, 200 Colorado Derby Building, Wichita, Kansas 67202, within 90 days after completion or recompletion of any well. Rule 82-3-130 and 82-3-107 apply. Information on side two of this form will be held confidential for a period of 12 months if requested in writing and submitted with the form. See rule 82-3-107 for confidentiality in excess of 12 months. One copy of all wireline logs and drillers time log shall be attached with this form. Submit CP-4 form with all plugged wells. Submit CP-111 form with all temporarily abandoned wells.

SIDE TWO

Operator Name Fred C. Berckefeldt Lease Name Burre Well # 2

Sec. 33 Twp. 8 Rge. 22 East West County Leavenworth

WELL LOG

INSTRUCTIONS: Show important tops and base of formations penetrated. Detail all cores. Report all drill stem tests giving interval tested, time tool open and closed, flowing and shut-in pressures, whether shut-in pressure reached static level, hydrostatic pressures, bottom hole temperature, fluid recovery, and flow rates if gas to surface during test. Attach extra sheet if more space is needed. Attach copy of log.

Drill Stem Tests Taken Yes No
 Samples Sent to Geological Survey Yes No
 Cores Taken Yes No

Formation Description
 Log Sample

Name	Top	Bottom
Upper McLoath	1336	1344
Lower McLoath	1354	1370
BURGESS	1402	1422

Date of First Production <u>12/17/86</u>	Producing Method <input checked="" type="checkbox"/> Flowing <input type="checkbox"/> Pumping <input type="checkbox"/> Gas Lift <input type="checkbox"/> Other (explain).....				
Estimated Production Per 24 Hours	Oil	Gas	Water	Gas-Oil Ratio	Gravity
	<u>0</u> Bbls	<u>400</u> MCF	<u>0</u> Bbls		CFPB

METHOD OF COMPLETION

Production Interval

Disposition of gas: Vented Open Hole Perforation 1401-1411
 Sold Other (Specify)
 Used on Lease Dually Completed

Purpose of String	Size Hole Drilled	Size Casing Set (in O.D.)	Weight Lbs/Ft.	Setting Depth	Type of Cement	#Sacks Used	Type and Percent Additives
surface	9 7/8"	7"	15.50	8.5'	P.H. A.	48	owc
longstring	6 1/2"	4 1/2"	9.0	14.35'	P.H. A.	153	60/40 P.S.

PERFORATION RECORD		Acid, Fracture, Shot, Cement Squeeze Record	
Shots Per Foot	Specify Footage of Each Interval Perforated	(Amount and Kind of Material Used)	Depth
<u>4</u>	<u>1401-1411</u>	<u>Natural</u>	

TUBING RECORD	Size <u>None</u>	Set At	Packer at	Liner Run <input type="checkbox"/> Yes <input type="checkbox"/> No
---------------	------------------	--------	-----------	--