

15027000300000

FORM 51 25M 3-49 PETROL


KANSAS

Clay

Section 24 Township 8 Range 3-EWell No. #1 ~~Fall~~ ConcordCompany K I Turner & Mandenhall

NORTH

WEST

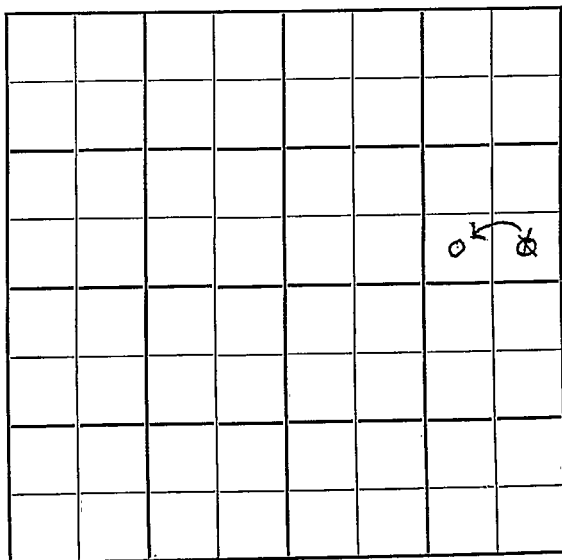

EAST

SOUTH

KANSAS

Clay

Sec. 24 Twp. 8 R. 3-E

Well No. #1 Fall Concord Farm

K I Turner & Mendenhall Company

Mendenhall Contractor

Wildcat


 Ft. from N. Line

330 Ft. from S. Line

990
330 Ft. from E. Line

 Ft. from W. Line

SW
SE SE NE

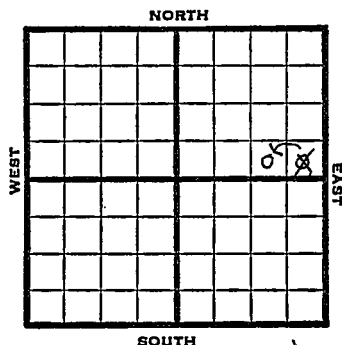

1950

Elev 1299

REPORT

8/2
9/6

MIM
TD 3000
8" @ 178
TD 3000 in Simp
no tops available
D&A

ABANDONED

Kansas

Map No. _____ Sec. 24 Twp. 8 R. 3EWell No. 1 Concord_____Turner & Mendenhall Company**CORRECTION** Contractor

SW SE NE

SECTION PLAT

			6

_____Ft. from N. Line330 Ft. from S. Line990 Ft. from E. Line_____Ft. from W. LineClay County

Location _____

Rig. up _____

Drilling and Remarks:

Reported
#1 Fall
SE SE NE

RECORD

Cased _____ in., _____ ft.

Sand _____

Gas _____

Oil _____

Total Depth _____

PRODUCTION

1st 24 hrs. Nat. _____

1st 24 hrs. after shot _____

Gas _____ Cu. Ft.

Dry Hole _____

Abandoned _____

Date

AUG 23 1950 19J. E. TYRA Scout

Kansas

Wildcat

Map No. _____ Sec. 24 Twp. 8 R. 3EWell No. 1 Fall

_____ K.I. Turner & Mendenhall _____ Company

_____ Mendenhall _____ Contractor

SE SE NE

SECTION PLAT


_____ Ft. from N. Line

330

_____ Ft. from S. Line

330 Ft. from E. Line

_____ Ft. from W. Line

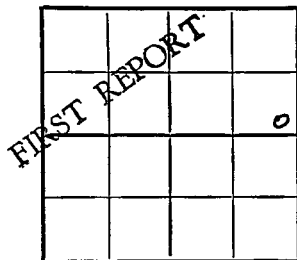

Clay County

Location _____

Rig up _____

Drilling and Remarks:

M I M

RECORD

Cased _____ in., _____ ft.

Sand _____

Gas _____

Oil _____

Total Depth _____

PRODUCTION

1st 24 hrs. Nat. _____

1st 24 hrs. after shot _____


Gas _____ Cu. Ft.

Dry Hole _____

Abandoned _____

Date

AUG 2 1950 19 J. E. TYRA Scout

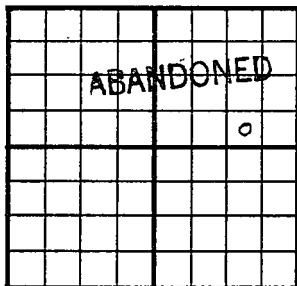County Clay State KansasSec. 24 (Blk.
Twp.) 8 (Sur.
Rge.) 3E Map No.Operator Turner & MendenhallWell No. 1 Farm ConcordElev. 1299 Location SW SE NE330 Ft. From S Line NE990 Ft. From E Line Quarter1st. ReportCompletion SEP 6 1950RemarksWildcatSpudding Date 8-21-50Drlg. Data D & A TD 30008" @ 178 TD 3000 in Simp. No tops availableD & A

J. E. TYRA