

KANSAS

Jefferson


FORM 51 5M 4-41 PETROL

150873064000

Section 29 Township 8 Range 20E

Well No. 1-Miller

Company Longwell et al

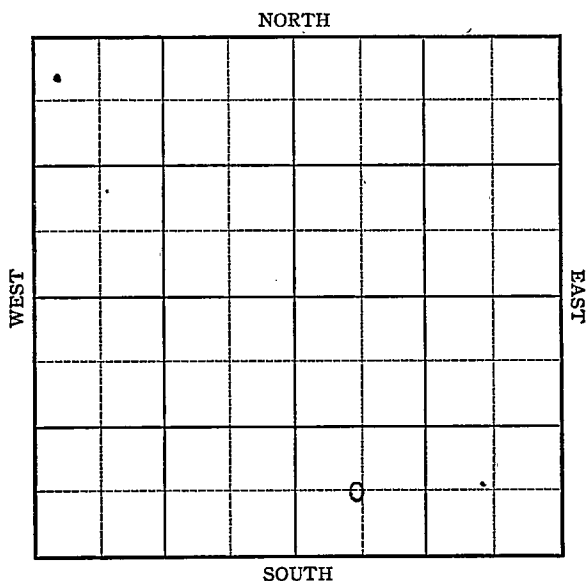

285 1075

Map No. _____ Sec. 29 Twp. 8 R. 20E

Well No. 1 Miller 38

Longwell etal _____ Company

FIRST REPORT

Contractor

C SW SE

_____ Ft. from N. Line

660 Ft. from S. Line

_____ Ft. from E. Line

660 Ft. from W. Line

MISCELLANEOUS

SECTION FLAT

Location _____

Rig up _____

Drilling and Remarks:

Drlg. 150'

RECORD

Cased _____ in., _____ ft.

Sand _____

Gas _____

Oil _____

Total Depth _____

PRODUCTION

1st 24 hrs. Nat. _____

1st 24 hrs. after shot _____

Gas _____ Cu. Ft.

Dry Hole _____

Abandoned _____

Date

SEP 3 1941 19

S. J. LEWIS Scout

Map No. NM Sec. 29 Twp. 8 R. 20EWell No. 1 MillerLongwell et al

Company

ABANDONED

Contractor

SECTION PLAT

C SW SE

Ft. from N. Line

660

Ft. from S. Line

Ft. from E. Line

660

Ft. from W. Line

MISCELLANEOUS

Location

Rig up

Drilling and Remarks:

Miss 1544NFW.

RECORD

Cased _____ in., _____ ft.

Sand _____

Gas _____

Oil _____

Total Depth 1740

PRODUCTION

1st 24 hrs. Nat. _____

1st 24 hrs. after shot _____

Gas _____ Cu. Ft.

Dry Hole _____

Abandoned _____

Date

SEP. 17 1941

19

S. J. LEWIS

Scout