

Section 10 Township 9 Range 4 EWell No. # 1 HowesCompany K. I. Turner et al

NORTH

WEST

EAST

SOUTH

Clay

KANSAS

Sec. 10 Twp. 9 R. 4 E

Well No. # 1 Howes Farm

K. I. Turner et al Company

Slusher Contractor

Wildcat


 Ft. from N. Line

990 Ft. from S. Line

330 Ft. from E. Line

 Ft. from W. Line

NE SE SW

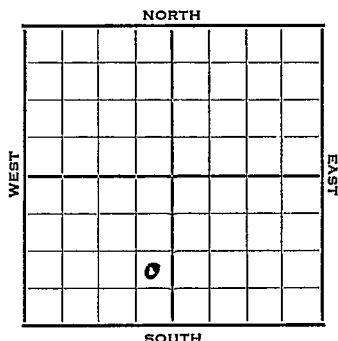

1952


Elev. - REPORT

6/11 Location

9/10 Spud -
D&A TD 1931
Burgess sd 1926 Miss Chat 1931
TD 1931 DST 1917-31 opn $\frac{1}{2}$ hr.
Rec. 5' vsocm 400# D&A

ABANDONED

County Clay State Kansas
 Sec. 10 (Blk. Twp.) 9 (Sur. Rge.) 4E Map No. _____
 Operator K. I. Turner et al.
 Well No. 1 Farm Howes
 Elev. _____ Location NE SE SW

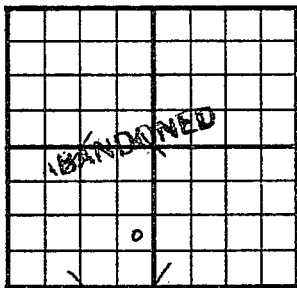

990 Ft. From S Line SW
330 Ft. From E Line Quarter

1st. Report

Completion SEP 10 1952

Remarks Wildcat

Slusser - Contr.

Spudding Date

Drig. Data D & A TD 1931


Burgess sd. 1926 Miss. chat 1931

TD 1931 DST 1917-31 open $\frac{1}{2}$ hr.

Rec. 5' vsocm 400#

D & A

J. G. McFEE

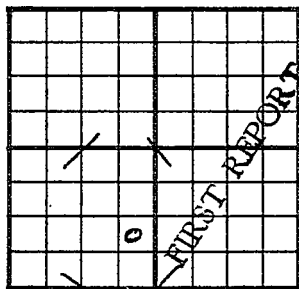County Clay State KansasSec. 10 (Blk. Twp.) 9 (Sur. Rge.) 4E Map No.Operator K. I. Turner et al.Well No. 1 Farm HowesElev. Location NE SE SW990 Ft. From S Line SW330 Ft. From E Line Quarter1st. Report JUN 11 1952

Completion

Remarks

Slusher - Contr.

Spudding Date

Drig. Data

WildcatLocation

J. G. McGEHEE