

FORM 51


Riley

Section 11 Township 9 Range 4E

KANSAS

Well No. #1 Llovelen

Company Salina Drlg.

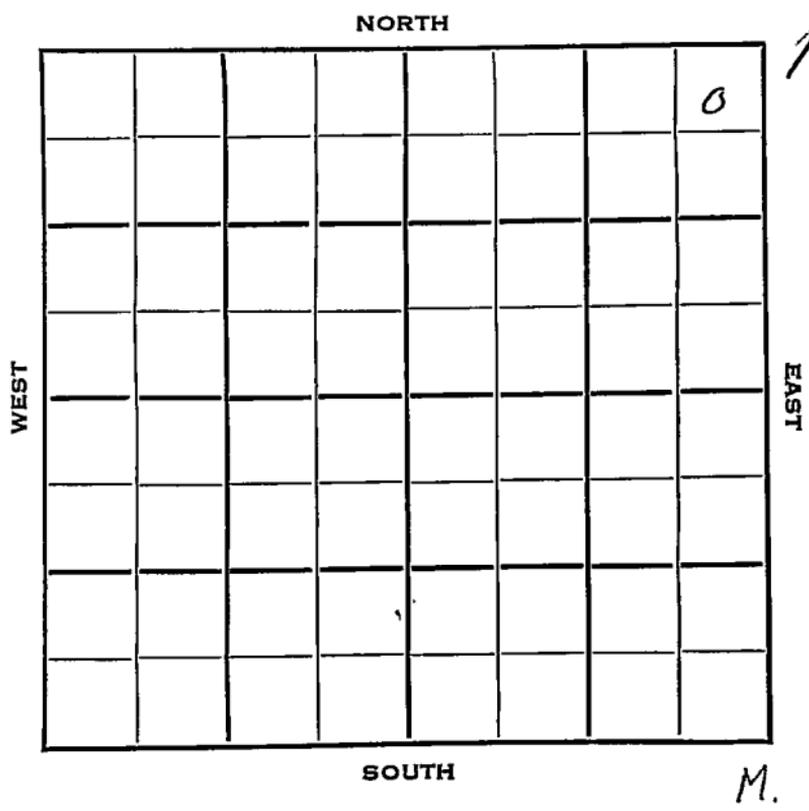

Sec. 11 Twp. 9 R. 4 E

Well No. # 1 Llovelen Farm

Salina Drlg. Company

Salina Drlg. Contractor

Wildcat


330 Ft. from N. Line

\_\_\_\_\_ Ft. from S. Line

330 Ft. from E. Line

\_\_\_\_\_ Ft. from W. Line

NE NE NE

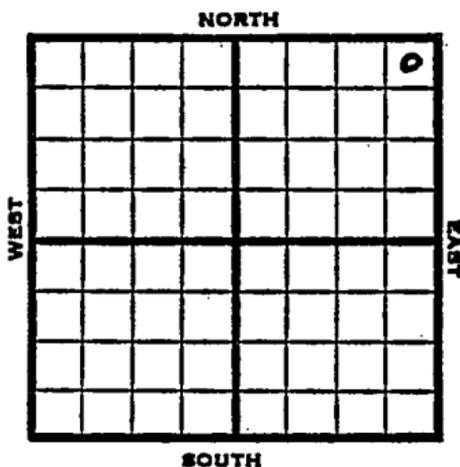

1953 Elev. 1294' REPORT

2/4 Spud 1-29-53  
8" @ 200

4/15 Spud 1-29-53  
D&A  
TD 2816  
8" @ 200  
Lans 1603, Marm. 1878, Marm. Im  
1901, Hunton 2082, Viola 2550, Simp  
2706, Granite 2813  
DST 2716-32, rec. 900' wtr., 970#,  
DST 2084-2105, rec. 56' wtr., 0#  
DST 1542-62, rec. 135' drlg mud  
TD 2816  
D&A

**ABANDONED**



