

15 027 00026 0000


FORM 51 25M 8-50 WESTERN

KANSAS

Section 15 Township 9 Range 4E

Well No. #1 Tannehill

Company K.I. Turner et al

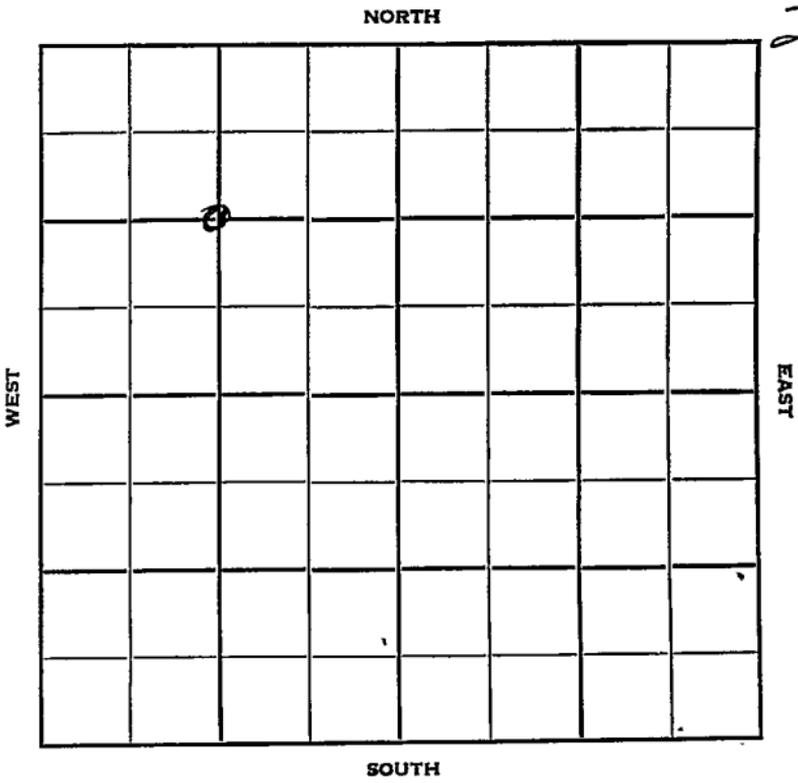

Clay KANSAS

Sec. 15 Twp. 9 R. 4 E

Well No. # 1 Tannehill Farm

K. I. Turner et al Company

Mendenhall-Contr. Contractor


Wildcat  
1320 Ft. from N. Line

\_\_\_\_\_ Ft. from S. Line

\_\_\_\_\_ Ft. from E. Line

1220 Ft. from W. Line

C NW/4

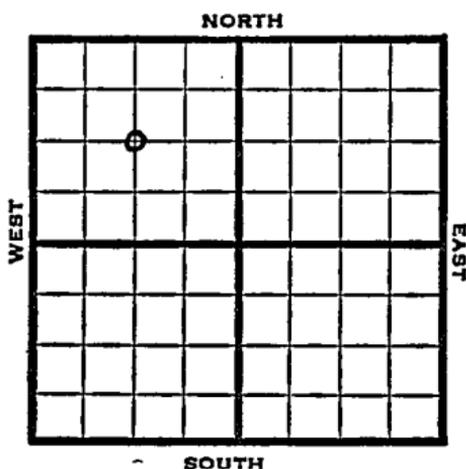

1951 Elev. 1287' REPORT

3/14 Spud 3-12-51  
8" @ 186'  
Drilling

6/13 Spud 3-12-51  
Oil well TD 1922' 8" @ 186  
Burgess 1904-10 Miss 1910'  
DST 1904-11 open 1 hr. rec 200' oily  
mud, 4 1/2" @ 1892 TD 1922'  
48/ in open hole Test 1 BOPD  
FU 920' oil 12 hr.  
Comp. 6 BOPD

**COMPLETED**


County Clay State Kansas

Sec. 15 (Blk.) 9 (Sur.) 4E Map No.

Operator K. I. Turner et al.

Well No. 1 Farm Tannehill

Elev. 1287 Location C NW/4

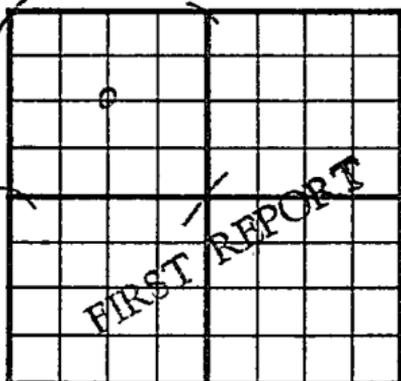

1320 Ft. From N Line NW

1220 Ft. From W Line Quarter

Ist. Report MAR 14 1951

Completion \_\_\_\_\_

Remarks \_\_\_\_\_

Mendenhall - Contr.

Spudding Date 3-12-51

Drlg. Data Wildcat

8" @ 186 drlg.

J. E. TYRA


County Clay State Kansas

Sec. 15 - (Blk. 9) (Sur. 4E) (Twp.) (Rge.) Map No.

Operator K. I. Turner etal.

Well No. 1 Farm Tannehill

Elev. 1287 Location C NW/4

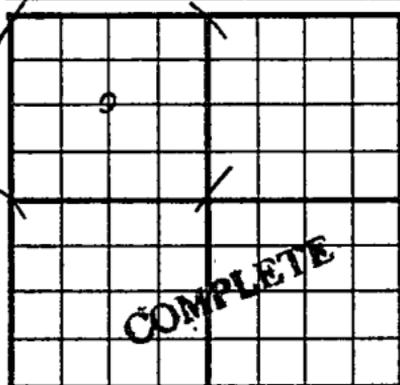

1320 Ft. From N Line NW

1320 Ft. From W Line Quarter

Ist. Report

Completion JUN 13 1951

Remarks Wildcat

Mendenhall - Contr.

Spudding Date 3-12-51

Drlg. Data Oil well TD 1922

8" @ 186 Burgess 1904-10

Miss. 1910 DST 1904-11 open 1 hr.

Rec. 200' oily mud 4 1/2" @ 1892

TD 1922 48/ in open hole

test 1 bopd FU 920' oil 12 hr.

Comp. 6 bopd

J. E. TYRA