


Section 15 Township 9 Range 4E

Well No. #2 Tannehill

Company K. I. Turner

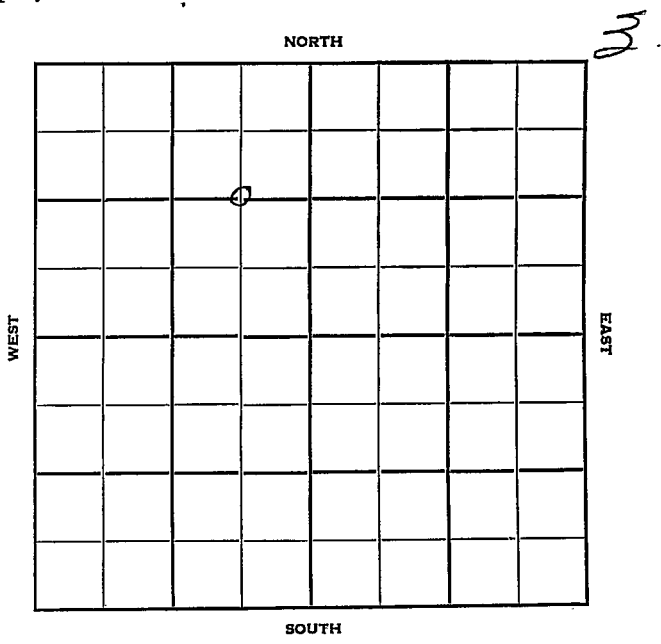

Clay

KANSAS



Sec. 15 Twp. 9 R. 4E

Well No. #2 Tannehill Farm

K. I. Turner Company

Contractor


1320' Ft. from N. Line

Ft. from S. Line


660' Ft. from E. Line

Ft. from W. Line

C E/2 NW

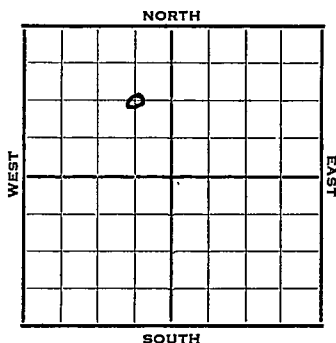

1952	Elev. -	REPORT
8/27	Spud 8-23-52 8" @208 Drlg.	
9/17	Spud 8-23-52 Oil Well TD 1934' 8" @ 208' Miss. 1919' 5" @ 1922' TD 1934' Hydro. S/ 5 boph Comp. 25 bopd	
		COMPLETED

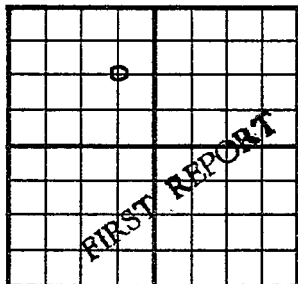County Clay State KansasSec. 15 (Blk.) 9 (Sur.) 4E Map No.Operator K. I. TurnerWell No. 2 Farm TannehillElev. Location C E/2 NW1320 Ft. From N Line NW660 Ft. From E Line Quarter1st. Report AUG 27 1952

Completion

Remarks


Spudding Date 8-23-52

Drlg. Data

8" @ 208 Drlg.

J. G. McGEHEE

County Clay State Kansas
 Sec. 15 (Bk.) 9 (Sur.) 4E Map No.
 Operator K. I. Turner
 Well No. 2 Farm Tannehill
 Elev. Location C E/2 NW

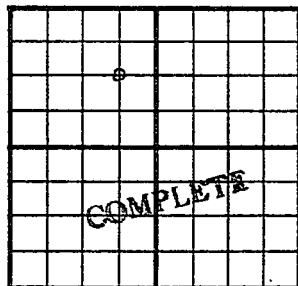

1320 Ft. From N Line NW
660 Ft. From E Line Quarter

Ist. Report

Completion SEP 17 1952

Remarks

Spudding Date 8-23-52

Drig. Data Oil well TD 1934

8" @ 208. Miss. 1919 5" @ 1922

TD 1934 Hydro. S/ 5 boph

Comp. 25 bopd

J. G. McGEHEE