


Jefferson

KANSAS

Section 15 Township 9 Range 20-E

Well No. #1 Courtney

Company Frank Whitten

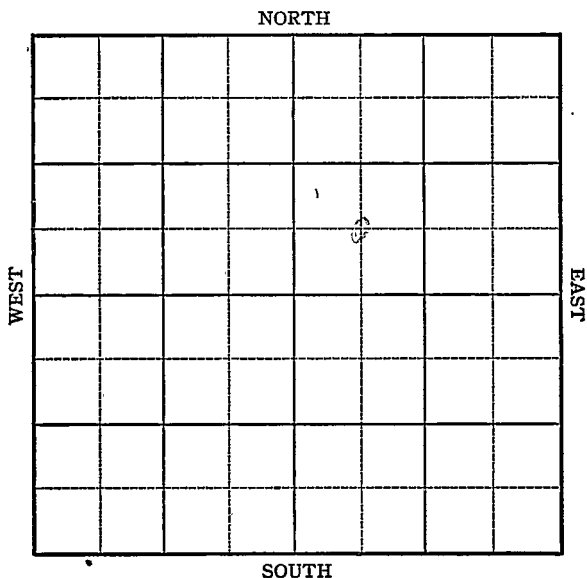

1942

3/19 TD 1170' SD.

3/26 1240' U.R. 8".

4/2 SD 1260'

4/8 "

4/15 "

4/22 "

4/29 Drlg. 1385'

5/6 1385' U.R. 8".

5/13 Sand 1348-75' T.D. 1392'
8" - 1310'
Shut down.

5/20 " "

5/27 " "

6/3 " "

6/10 " "

6/17 " "

6/24 Sand 1348'
T.D. 1392'
No shows.

ABANDONED

Map No. MM Sec. 15 Twp. 9 R. 20EWell No. 1 CourtneyFrank Whitten Company**FIRST REPORT**

Contractor

C S N NE

SECTION PLAT

		o	

 Ft. from N. Line660 Ft. from S. Line Ft. from E. Line660 Ft. from W. Line**MISCELLANEOUS**Location Rig up

Drilling and Remarks:

Spud

RECORDCased in., ft.Sand Gas Oil Total Depth **PRODUCTION**1st 24 hrs. Nat. 1st 24 hrs. after shot Gas Cu. Ft.Dry Hole Abandoned

Date

NOV 19 1941

19

S. J. LEWIS

Scout

Misc. Small Maps

Cards

Tracing

France Map

Scarborough Map

Moody Map

Geological Dept.

Moody Flat Book

Jefferson

KANSAS

Map No. MM Sec. 15 Twp. 9 R. 20EWell No. 1 CourtneyFrank Whitten Company**ABANDONED** Contractor

C S W N E

SECTION PLAT

		o	

 Ft. from N. Line660 Ft. from S. Line Ft. from E. Line660 Ft. from W. Line

MISCELLANEOUS

Location Rig up

Drilling and Remarks:

Shovel 1348.No show

RECORD

Cased in., ft.Sand Gas Oil Total Depth 1392

PRODUCTION

1st 24 hrs. Nat. 1st 24 hrs. after shot Gas Cu. Ft.Dry Hole Abandoned

Date

JUN 24 194219S. J. LEWIS Scout

Misc Small Maps	
Cards	
Tracing	
France Map	
Scarborough Map	
Moody Map	
Geological Dept.	
Moody Plat Book	