

KANSAS


Leavenworth

FORM 51 5M 10-41 PETROL

Section 15 Township 9 Range 20-E

Well No. #1 Edmonds

Company McLaughlin

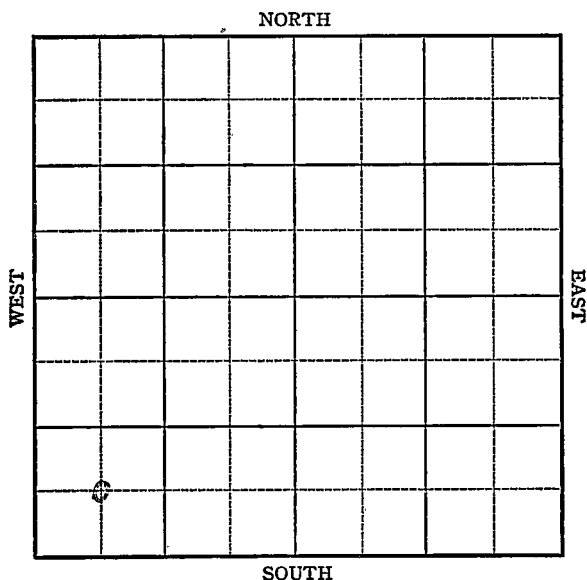

Map No. NM Sec. 15 Twp. 9 R. 20EWell No. 1 EdmondsMcLaughlin CompanyFIRST REPORT Contractor
C SW SW

SECTION PLAT

 Ft. from N. Line660 Ft. from S. Line Ft. from E. Line660 Ft. from W. LineMCLOUTH POOLLocation Rig up

Drilling and Remarks:

Dr1 g. 180'

RECORD

Cased in., ft.Sand Gas Oil Total Depth

PRODUCTION

1st 24 hrs. Nat. 1st 24 hrs. after shot Gas Cu. Ft.Dry Hole Abandoned

Date

MAY 6 1942 19 S. J. LEWIS Scout

Leavenworth

Map No. MM Sec. 15 Twp. 9 R. 20EWell No. 1 EdmondsMcLaughlin CompanyABANDONED Contractor

C SW SW

SECTION PLAT

0			

 Ft. from N. Line660 Ft. from S. Line Ft. from E. Line660 Ft. from W. Line

MCLOUTH POOL

Location Rig up

Drilling and Remarks:

Bar 8/1488Miss 1518No. 1 wire

RECORD

Cased in., ft.Sand Gas Oil Total Depth 1531

PRODUCTION

1st 24 hrs. Nat. 1st 24 hrs. after shot Gas Cu. Ft.Dry Hole Abandoned

Date

MAY 27 1942 19S. J. LEWIS Scout