

# KANSAS

# Leavenworth


FORM 51 5M 4-41 PETROL

Section 15 Township 9 Range 20-E

Well No. #1 Brooks Houston

Company E. V. Jackson

NORTH McLouth Pool

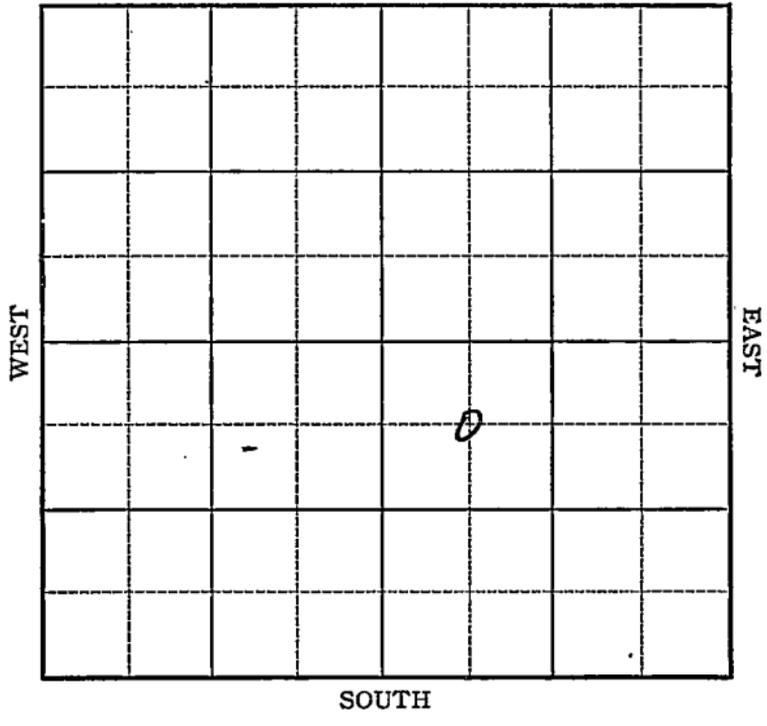

Sec. 15 Twp. 9 R. 20-E

Well No. #1 Brooks Houston Farm

E. V. Jackson Company


(McLouth)

660 Ft. from N. Line

         Ft. from S. Line

         Ft. from E. Line

660 Ft. from W. Line

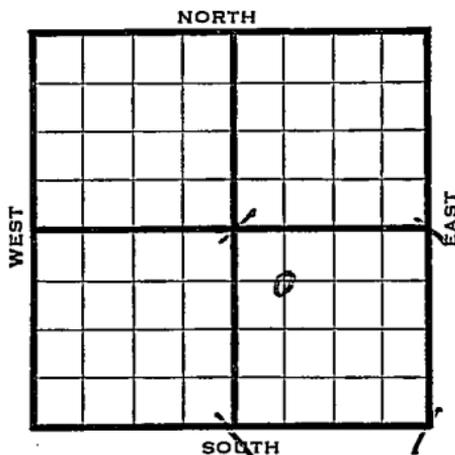

1942

REPORT

6/24	Location
7/1	Spud 30'
7/8	Drlg. 310'
7/15	10" - 70' Drlg. 740'
7/22	8" - 1000' Drlg. 1020'
7/29	Shut down 1020'
8/5	T.D. 1453 S.D.
8/12	Miss. 1445 no shows T.D. 1453

**ABANDONED**

Leavenworth **KANSAS**Map No. MM Sec. 15 Twp. 9 R. 20EWell No. 1 BrooksE. V. Jackson

Company

**FIRST REPORT**

Contractor

C NW SE


660 Ft. from N. Line

\_\_\_\_\_ Ft. from S. Line

\_\_\_\_\_ Ft. from E. Line

660 Ft. from W. Line

## SECTION PLAT

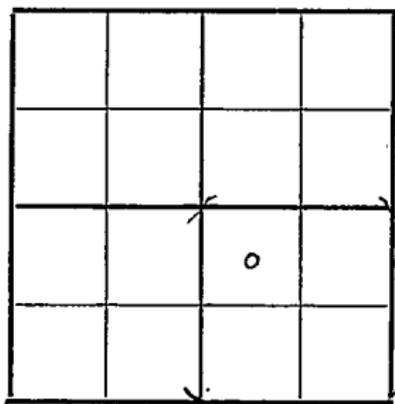

MCLOUTH POOL

Location XXX

Rig up \_\_\_\_\_

Drilling and Remarks:

## RECORD

Cased \_\_\_\_\_ in., \_\_\_\_\_ ft.

Sand \_\_\_\_\_

Gas \_\_\_\_\_

Oil \_\_\_\_\_

Total Depth \_\_\_\_\_

## PRODUCTION

1st 24 hrs. Nat. \_\_\_\_\_

1st 24 hrs. after shot \_\_\_\_\_

Gas \_\_\_\_\_ Cu. Ft.

Dry Hole \_\_\_\_\_

Abandoned \_\_\_\_\_

Date

JUN 24 1942

19

S. J. LEWIS

Scout

## Leavenworth

Map No. MM Sec. 15 Twp. 9 R. 20EWell No. 1 HoustonE. V. Jackson

Company

CORRECTION

Contractor

C NW SE

660 Ft. from N. Line

\_\_\_\_\_ Ft. from S. Line

\_\_\_\_\_ Ft. from E. Line

660 Ft. from W. Line

## SECTION PLAT

		D	

## MCLOUTH POOL

Location \_\_\_\_\_

Rig up \_\_\_\_\_

Drilling and Remarks:

Reported as

#1 Brooks

## RECORD

Cased \_\_\_\_\_ in., \_\_\_\_\_ ft.

Sand \_\_\_\_\_

Gas \_\_\_\_\_

Oil \_\_\_\_\_

Total Depth \_\_\_\_\_

## PRODUCTION

1st 24 hrs. Nat. \_\_\_\_\_

1st 24 hrs. after shot \_\_\_\_\_

Gas \_\_\_\_\_ Cu. Ft.

Dry Hole \_\_\_\_\_

Abandoned \_\_\_\_\_

Date

JUL 15 1942 19

S. J. LEWIS

Scout

Map No. MM Sec. 15 Twp. 9 R. 20E

Well No. 1 Houston  
E. V. Jackson Company

ABANDONED Contractor

C NW SE

660 Ft. from N. Line

\_\_\_\_\_ Ft. from S. Line

\_\_\_\_\_ Ft. from E. Line

660 Ft. from W. Line

McLouth Pool

SECTION PLAT

		a	

Location \_\_\_\_\_

Rig up \_\_\_\_\_

Drilling and Remarks:

*Miss 1445*

*No show*

RECORD

Cased \_\_\_\_\_ in., \_\_\_\_\_ ft.

Sand \_\_\_\_\_

Gas \_\_\_\_\_

Oil \_\_\_\_\_

Total Depth 1459

PRODUCTION

1st 24 hrs. Nat. \_\_\_\_\_

1st 24 hrs. after shot \_\_\_\_\_

Gas \_\_\_\_\_ Cu. Ft.

Dry Hole \_\_\_\_\_

Abandoned \_\_\_\_\_

Date

AUG 12 1942 19

S. J. LEWIS Scout