

15 103 00004 0000

FORM 51 5M BR1X


KANSAS

Leavenworth County

Section 16 Township 9 Range 22E

Well No. #1 Sloan

Company Mosbacher

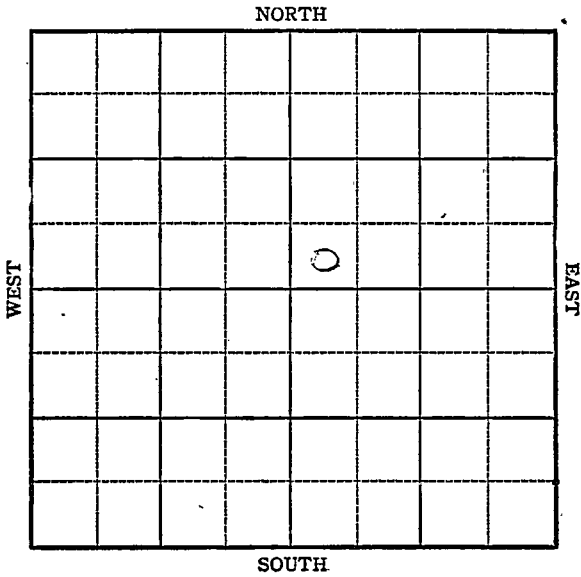

KANSAS Leavenworth County

Sec. 16 Twp. 9 R. 22E

Well No. #1 Sloan Farm

Mosbacher Company

McLouth


\_\_\_\_\_ Ft. from N. Line

330 Ft. from S. Line

\_\_\_\_\_ Ft. from E. Line

330 Ft. from W. Line

SW NE

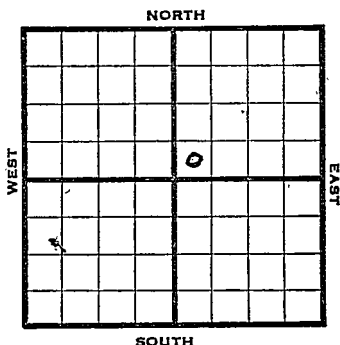

1944

**959** R E P O R T

9/20	Drlg. 270'
9/28	" "
10/4	10" @ 170 8" @ 673 Drlg. 810
10/11	" " "
10/18	B. Herta 500      Lans 175 6" @ 1030      Drlg. 1252
10/25	55" @ 1298      Drlg. 1380
11/1	Miss. 1290 <del>TD 1460</del> HFV

**ABANDONED**

60

Pool Name McLouth

Map No. KANSAS Sec. 16 Twp. 9 R. 22E

Well No. 1 Sloan

Mosbacher Company

FIRST REPORT Contractor

SW NE

SECTION PLAT

\_\_\_\_\_ Ft. from N. Line

330 Ft. from S. Line

\_\_\_\_\_ Ft. from E. Line

330 Ft. from W. Line

		o	

Leavenworth County

Location \_\_\_\_\_

Rig up \_\_\_\_\_

Drilling and Remarks:

270'

RECORD

Cased \_\_\_\_\_ in., \_\_\_\_\_ ft.

Sand \_\_\_\_\_

Gas \_\_\_\_\_

Oil \_\_\_\_\_

Total Depth \_\_\_\_\_

PRODUCTION

1st 24 hrs. Nat. \_\_\_\_\_

1st 24 hrs. after shot \_\_\_\_\_

Gas \_\_\_\_\_ Cu. Ft.

Dry Hole \_\_\_\_\_

Abandoned \_\_\_\_\_

Date

SEP 20 1944 19

S. J. LEWIS Scout

Pool Name McLouth

Map No. 111M Sec. 16 Twp. 9 R. 22E

Well No. 1 Sloan

Mosbacher Company

**ABANDONED**

Contractor

**SW NE**

**SECTION PLAT**


         Ft. from N. Line

330 Ft. from S. Line

         Ft. from E. Line

330 Ft. from W. Line

Leavenworth

Location         

Rig up         

Drilling and Remarks:

*Miss 1290*

*HFW*

**RECORD**

Cased          in.,          ft.

Sand         

Gas         

Oil         

Total Depth 1468

**PRODUCTION**

1st 24 hrs. Nat.         

1st 24 hrs. after shot         

Gas          Cu. Ft.

Dry Hole         

Abandoned         

Date.

NOV 1 1944

S. J. LEWIS Scout