

KANSAS

Jefferson


FORM 51 5M 4-41 PETROL

Section 16 Township 9 Range 20-E

Well No. #1 Tabor Edmonds

Company Hatcher & Fisk

NORTH McLouth Pool

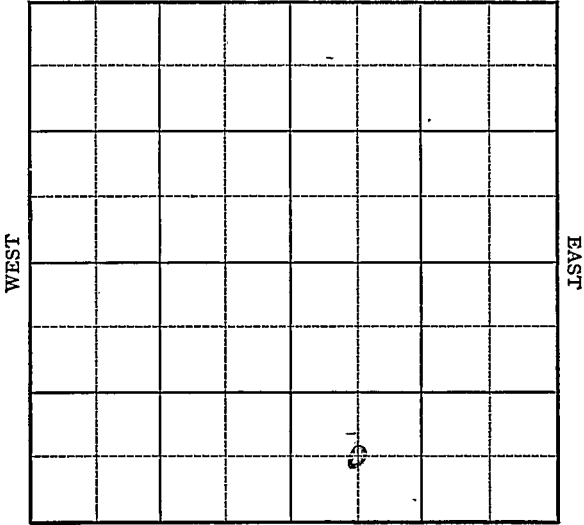

SOUTH

Jefferson KANSAS

Map No. ~~16~~ Sec. 16 Twp. 9 R. 20E

Well No. 1 Tabor Edmonds

Hatcher & Fisk Company

FIRST REPORT Contractor

C SW SE


SECTION PLAT

_____ Ft. from N. Line

660 Ft. from S. Line

_____ Ft. from E. Line

660 Ft. from W. Line

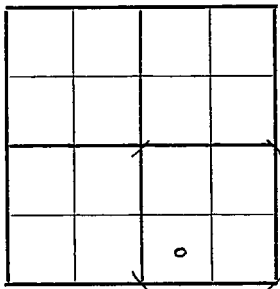

MCLOUTH POOL

Location _____

Rig up _____

Drilling and Remarks:

10" - 58'

Dr 1 g. 165'

RECORD

Cased _____ in., _____ ft.

Sand _____

Gas _____

Oil _____

Total Depth _____

PRODUCTION

1st 24 hrs. Nat. _____

1st 24 hrs. after shot _____

Gas _____ Cu. Ft.

Dry Hole _____

Abandoned _____

Date

MAY 20 1942

19

S. J. LEWIS Scout

Map No. MM Sec. 16 Twp. 9 R. 20E

Well No. 1 Tabor Edmonds

Hatcher & Fisk Company

COMPLETED

Contractor

C SW SE

SECTION PLAT

_____ Ft. from N. Line

660 Ft. from S. Line

_____ Ft. from E. Line

660 Ft. from W. Line

| | | | |
|--|--|--|--|
| | | | |
| | | | |
| | | | |
| | | | |
| | | | |

MCLOUTH POOL

Location _____

Rig up _____

Drilling and Remarks:

*Drilled 1388.
5" @ 1388
5 1/2 Gas*

RECORD

Cased _____ in., _____ ft.

Sand _____

Gas _____

Oil _____

Total Depth 1399

PRODUCTION

1st 24 hrs. Nat. _____

1st 24 hrs. after shot _____

Gas _____ Cu. Ft.

Dry Hole _____

Abandoned _____

Date

JUN 10 1942 19

S. J. LEWIS

Scout