


Section 16 Township 9 Range 20-E

Well No. #1 Rachel Edmonds

Company Ray Anderson

NORTH McLouth Pool

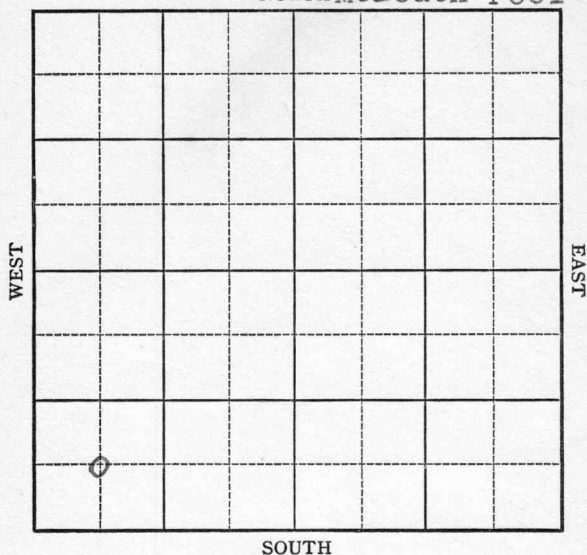

Sec. 16 Twp. 9 R. 20-E

Well No. #1 Rachel Edmonds Farm

Ray Anderson Company


(McLouth)

 Ft. from N. Line

660 Ft. from S. Line

 Ft. from E. Line

660 Ft. from W. Line

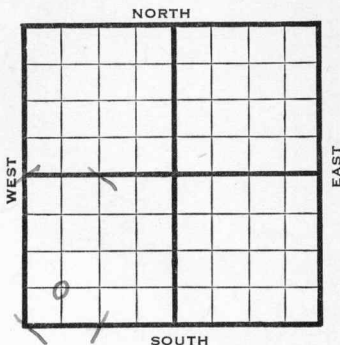

1942

REPORT

7/1	10" - 28' Drlg. 358'
7/8	8" - 813' TD 1200' SD.
7/15	6" - 1193' Sand 1353-56' T.D. 5" - 1330' WOC. S/Gas
7/22	5" @ 1330' Sand 1353' T.D. 1366' 4,300,000 gas.

COMPLETED

Jefferson

KANSAS

Map No. MM Sec. 16 Twp. 9 R. 20EWell No. 1 Rachel EdmondsRay Anderson


Company

FIRST REPORT

Contractor

C SW SW

SECTION PLAT

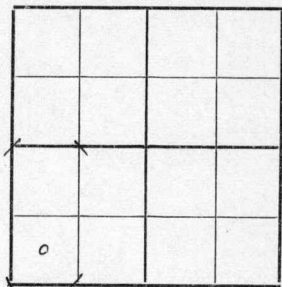 Ft. from N. Line660 Ft. from S. Line Ft. from E. Line660 Ft. from W. Line

McLouth Pool

RECORD

Location Cased in., ft.Rig up Sand

Drilling and Remarks:

Gas 10" - 28'Oil Total Depth Drlg. 358'

PRODUCTION

1st 24 hrs. Nat. 1st 24 hrs. after shot Gas Cu. Ft.Dry Hole Abandoned

Date

JUL 1 194219S. J. LEWIS Scout

Map No. MM Sec. 16 Twp. 9 R. 20E

Well No. 1 Rachel Edmonds

Ray Anderson Company

COMPLETED Contractor

C SW SW

 Ft. from N. Line

660 Ft. from S. Line

 Ft. from E. Line

660 Ft. from W. Line

McLOUTH POOL

SECTION PLAT

RECORD

Location

Rig up

Drilling and Remarks:

San. 1353
5" @ 1330
4,300,000 Gas

Cased in., ft.

Sand

Gas

Oil

Total Depth 1366

PRODUCTION

1st 24 hrs: Nat.

1st 24 hrs. after shot

Gas Cu. Ft.

Dry Hole

Abandoned

Date

JUL 22 1942 19 S. J. LEWIS Scout