

Map No. _____ Sec. 20 Twp. 9 R. 4Well No. 1 Farm _____Baquet et al Company

NORTH

WEST

EAST

SOUTH

Location _____

Drilling Remarks _____

Rig Up _____

Drilling Remarks _____

RECORD

Cased _____ in. _____ ft.

Sand _____

Gas _____

Oil _____

Total Depth _____

PRODUCTION

1st 24 hrs. Nat. _____

1st 24 hrs. after shot _____

Gas _____ cu. ft.

Dry Hole _____

Abandoned _____

Clay Co

Map No. 1 Kansas Sec. 20 Twp. 9 R. 4EWell No. 1 FarmBagus et al Company

NORTH


200 Ft. from N. Line

..... Ft. from S. Line

200 Ft. from E. Line

..... Ft. from W. Line

WEST

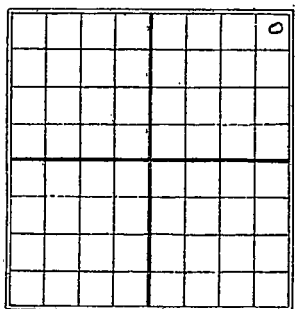

EAST

SOUTH

Date

1926

REPORT

3/31

T.D. 1890

D. & Q. 1890

MAP NO. KANSAS SEC. 20 TWP. 15 R. 4E

WELL NO. 1

Borg et al COMPANY

CONTRACTOR

SECTION PLAT

			0

ABANDONED

_____ FT. FROM N. LINE

_____ FT. FROM S. LINE

_____ FT. FROM E. LINE

_____ FT. FROM W. LINE

RECORD

LOCATION _____

CASED _____ IN. _____ FT.

RIG UP _____

SAND _____

DRILLING AND REMARKS:

GAS _____

OIL _____

TOTAL DEPTH 1855

PRODUCTION

1ST 24 HRS. NAT. _____

1ST 24 HRS. AFTER SHOT _____

GAS _____ CU. FT.

DRY HOLE ☒

ABANDONED ☒

DATE

6/26 1924 SCOUT

Map No. **KANSAS** Sec. 20 Twp. 9 R. 4E

Well No. 1

Bagns et al Company

Contractor

SECTION PLAT

200 Ft. from N. Line

_____ Ft. from S. Line

200 Ft. from E. Line

FIRST REPORT

_____ Ft. from W. Line

ABANDONED

			0

Location _____

Rig up _____

Drilling and Remarks:

T. II 1890

II & A.

RECORD

Cased _____ in., _____ ft.

Sand _____

Gas _____

Oil _____

Total Depth _____

PRODUCTION

1st 24 hrs. Nat. _____

1st 24 hrs. after shot _____

Gas _____ Cu. Ft.

Dry Hole _____

Abandoned _____

Date

MAR 31 1926

S. J. LEWIS

Scout