



Sec. 20 Twp. 9 R. 20 E

Well No. #2 Todd Farm

Smyth & Miller Company


McLouth Pool

\_\_\_\_\_ Ft. from N. Line

920 Ft. from S. Line

375 Ft. from E. Line

\_\_\_\_\_ Ft. from W. Line

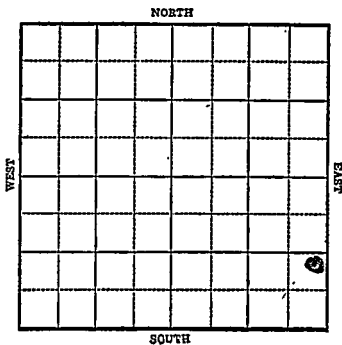

1942

R E P O R T

11/4 Machine  
 11/11 10" @ 90'  
 Drlg. 710'  
 11/18 Drlg 1185'  
 11/24 6" @ 1425'  
 Bart. 1425  
 T.D. 1453 $\frac{1}{2}$ '  
 11,650,000 Gas

**COMPLETED**

Map No. KANSAS Sec. 20 Twp. 9 R. 20E

Well No. 2 Todd

Smyth & Miller Company

FIRST REPORT Contractor

. NE SE SE

SECTION PLAT

\_\_\_\_\_ Ft. from N. Line

920 Ft. from S. Line

375 Ft. from E. Line

\_\_\_\_\_ Ft. from W. Line

			0

MCLOUTH POOL

Location \_\_\_\_\_

Rig up \_\_\_\_\_

Drilling and Remarks:

Machine

RECORD

Cased \_\_\_\_\_ in., \_\_\_\_\_ ft.

Sand \_\_\_\_\_

Gas \_\_\_\_\_

Oil \_\_\_\_\_

Total Depth \_\_\_\_\_

PRODUCTION

1st 24 hrs. Nat. \_\_\_\_\_

1st 24 hrs. after shot \_\_\_\_\_

Gas \_\_\_\_\_ Cu. Ft.

Dry Hole \_\_\_\_\_

Abandoned \_\_\_\_\_

Date

NOV 4 1942 19

S. J. LEWIS Scout

**KANSAS**Map No. MM Sec. 20 Twp. 9 R. 20EWell No. 2 ToddSmyth & Miller Company**COMPLETED** Contractor

NE SE SE

## SECTION PLAT

         Ft. from N. Line920 Ft. from S. Line375 Ft. from E. Line         Ft. from W. Line

			6

MCLOUTH POOL

Location                                 Rig up                                 

Drilling and Remarks:

*Bar 8 1425**6" @ 1425**11,650,000 Gas*

## RECORD

Cased          in.,          ft.Sand                                 Gas                                 Oil                                 Total Depth 1453 1/4

## PRODUCTION

1st 24 hrs. Nat.                         1st 24 hrs. after shot                         Gas                                  Cu. Ft.Dry Hole                                 Abandoned                                 Date         NOV 24 1942 19S. I. LEWIS Scout