


Section 20 Township 9 Range 20E

Well No. 4 Hesse

Company Hatcher & Fisk

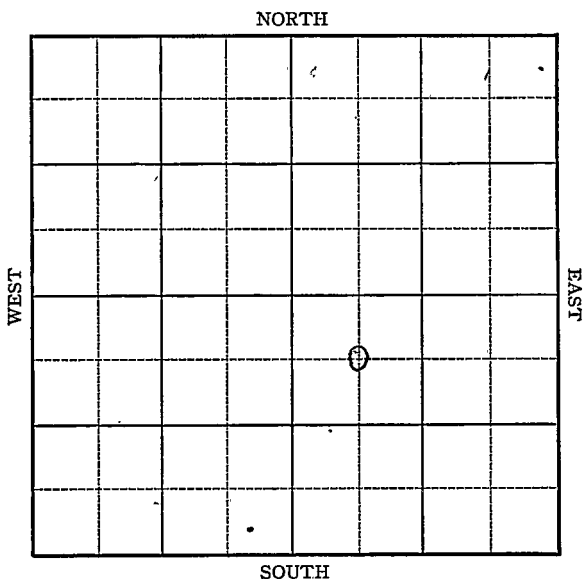

KANSAS

Sec. 20- Twp. 9- R. 20E

Well No. #4 Hesse Farm

Hatcher & Fisk Company

(McLouth Pool)


660 Ft. from N. Line

_____ Ft. from S. Line

_____ Ft. from E. Line

660 Ft. from W. Line

C NW SE

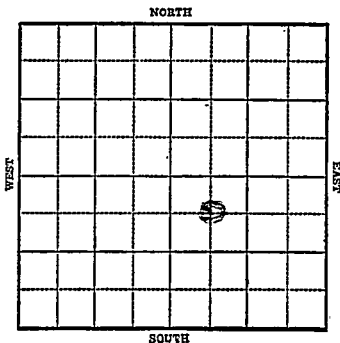

1942

R E P O R T

11/4 Location

11/11 SD 225'

11/18 Drlg. 785
10" @ 38'

11/24 5" @ 1357'
Bart. 1357
T.D. 1370'
4,900,000 Gas

COMPLETED

KANSAS

Jefferson

Map No. MM Sec. 20 Twp. 9 R. 20EWell No. 4 HesseHatcher & Fisk CompanyFIRST REPORT Contractor

C NW SE

660 Ft. from N. Line

_____ Ft. from S. Line

_____ Ft. from E. Line

660 Ft. from W. Line

SECTION PLAT

		o	

MCCLOUTH POOLLocation XXX

Rig up _____

Drilling and Remarks:

RECORD

Cased _____ in., _____ ft.

Sand _____

Gas _____

Oil _____

Total Depth _____

PRODUCTION

1st 24 hrs. Nat. _____

1st 24 hrs. after shot _____

Gas _____ Cu. Ft.

Dry Hole _____

Abandoned _____

Date

NOV 4 1942 19

S. J. LEWIS Scout

KANSAS

Map No. MM Sec. 20 Twp. 9 R. 20E

Well No. 4 Hesse

Hatcher & Fisk Company

COMPLETED

Contractor

C NW SE

SECTION PLAT

660 Ft. from N. Line

_____ Ft. from S. Line

_____ Ft. from E. Line

660 Ft. from W. Line

		•	

M CLOUTH P O O L

RECORD

Location _____

Cased _____ in., _____ ft.

Rig up _____

Sand _____

Drilling and Remarks:

Gas _____

Box 8 1357

Oil _____

5" @ 1357

Total Depth 1321

4,900,000 Gas

PRODUCTION

1st 24 hrs. Nat. _____

1st 24 hrs. after shot _____

Gas _____ Cu. Ft.

Dry Hole _____

Abandoned _____

Date

NOV 24 1942 19

S. J. LEWIS Scout