


Section 20 Township 9 Range 20-E

Well No. #5 McLouth Bank

Company E. V. Jackson etal

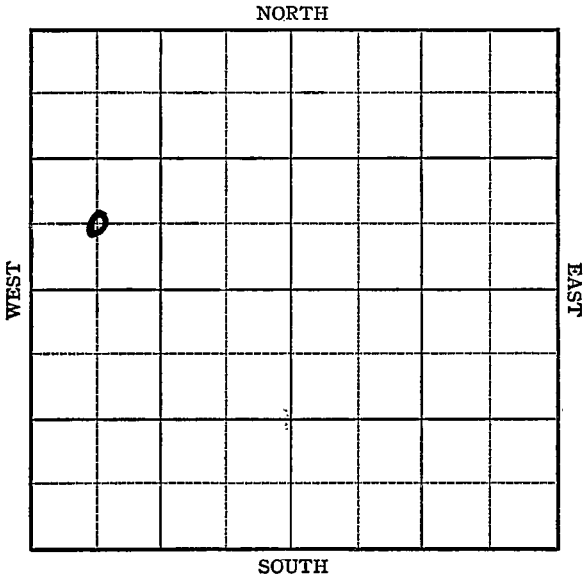

M

Sec. 20 Twp. 9 R. 20-E

Well No. #3 McLouth Bank Farm
E. V. Jackson et al Company


_____ Ft. from N. Line

660 Ft. from S. Line

_____ Ft. from E. Line

660 Ft. from W. Line

Elev. 1056

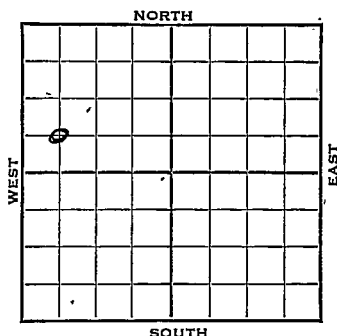

1942

REPORT

7/22	Machine	
7/29	10" - 75'	Drlg. 535'
8/5	8" - 900	Drlg. 1015'
8/12	1015 fsg.	
8/19	"	
8/27	"	
9/2	Fishing 1160'	
9/9	"	
9/16	"	
9/23	"	
9/30	Drlg. 1165'	
10/7	Miss. 1482	no shows
	T.D. 1487	

ABANDONED

Map No. MM Sec. 20 Twp. 9 R. 20EWell No. 3 McLouth BankE. V. Jackson et al. Company**FIRST REPORT** Contractor

C SW NW

SECTION PLAT

_____ Ft. from N. Line

660 Ft. from S. Line

_____ Ft. from E. Line

660 Ft. from W. Line

o			

MCLOUTH POOL

Location _____

Rig up _____

Drilling and Remarks:

Machine

RECORD

Cased _____ in., _____ ft.

Sand _____

Gas _____

Oil _____

Total Depth _____

PRODUCTION

1st 24 hrs. Nat. _____

1st 24 hrs. after shot _____

Gas _____ Cu. Ft.

Dry Hole _____

Abandoned _____

Date

JUL 22 1942

19

S. J. LEWIS Scout

Map No. N/M Sec. 20 Twp. 9 R. 20EWell No. 3 McLouth BankE. V. Jackson et al. CompanyABANDONED Contractor

C SW NW

_____ Ft. from N. Line

660 Ft. from S. Line

_____ Ft. from E. Line

660 Ft. from W. Line

SECTION PLAT

o			

MCLOUTH POOL

Location _____

Rig up _____

Drilling and Remarks:

*Miss 1482**No show*

RECORD

Cased _____ in., _____ ft.

Sand _____

Gas _____

Oil _____

Total Depth 1487

PRODUCTION

1st 24 hrs. Nat. cf

1st 24 hrs. after shot _____

Gas _____ Cu. Ft.

Dry Hole _____

Abandoned _____

Date

OCT 7 1942 19

S. J. LEWIS Scout