

KANSAS

FORM 51 5M 1-42 PETROL


Jefferson

Section 20 Township 9 Range 20-E

Well No. #2 Zachariah

Company Hodge et al.

McLouth pool

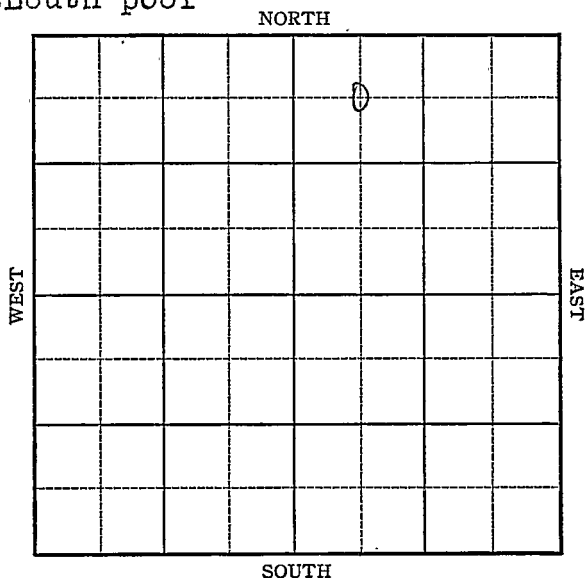

KANSAS

Jefferson

Sec. 20 Twp. 9 R. 20E

Well No. #2 Zachariah Farm

Hodge et al. Company


MClouth Pool

5660 Ft. from N. Line

 Ft. from S. Line

 Ft. from E. Line

660 Ft. from W. Line

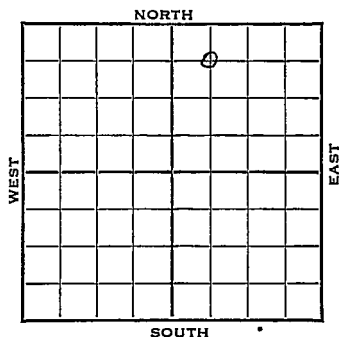

C NW NE

1942

REPORT

11/10

Spud

11/18

Drilg. 725&
10" @ 37'

11/24

Bart. 1385
Miss. 1422
T.D. 1422'
No shows

ABANDONED

KANSAS

Map No. MM Sec. 20 Twp. 9 R. 20EWell No. 2 Z achariahHodge etal. CompanyFIRST REPORT Contractor

CNW NE

660 Ft. from N. Line Ft. from S. Line Ft. from E. Line660 Ft. from W. Line

SECTION PLAT

		o	

MCLOUTH POOL

Location Rig up

Drilling and Remarks:

Spud

RECORD

Cased in., ft.Sand Gas Oil Total Depth

PRODUCTION

1st 24 hrs. Nat. 1st 24 hrs. after shot Gas Cu. Ft.Dry Hole Abandoned

Date

NOV 11 1942 19S. J. LEWIS Scout

Jefferson

KANSAS

Map No. N 11 Sec. 20 Twp. 9 R. 20EWell No. 2 ZachariahHodge et al. CompanyABANDONED Contractor

C NW NE

SECTION PLAT

660 Ft. from N. Line Ft. from S. Line Ft. from E. Line660 Ft. from W. Line

		0	

MCLOUTH POOL

Location Rig up

Drilling and Remarks:

*Bar 8/385**W is 1422**No show*

RECORD

Cased in., ft.Sand Gas Oil Total Depth 1422

3 PRODUCTION

1st 24 hrs. Nat. 1st 24 hrs. after shot Gas Cu. Ft.Dry Hole Abandoned

Date

NOV 24 1942 19 S. J. LEWIS Scout