

KANSAS

FORM 51 5M 4-41 PETROL


Jefferson

Section 20 Township 9 Range 20-E

Well No. #1 Hesse

Company Hatcher & Fisk

NORTH McLouth Pool

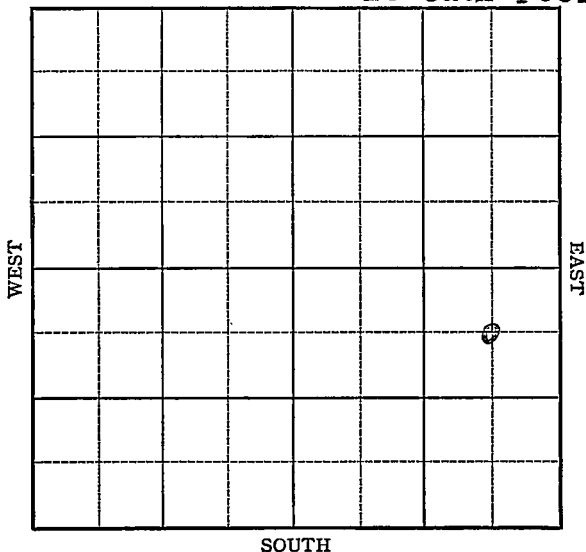

Sec. 20 Twp. 9 R. 20-E

Well No. #1 Hesse Farm

Hatcher & Fisk Company


(McLouth)

660 Ft. from N. Line

_____ Ft. from S. Line

660 Ft. from E. Line

_____ Ft. from W. Line

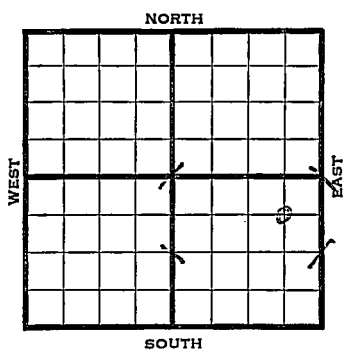

1942	REPORT
6/17	Spud.
6/24	10" - 88' Drlg. 1000'
7/1	8" - 850' Bart. 1400' T.D. 1423'
	5" - 1400' Est. 2 $\frac{1}{2}$ M gas.
7/8	Sand 1400'
	5" - 1400'
	T.D. 1423'
	2-3/4 M gas.
	COMPLETED

KANSAS

Jefferson

Map No. MM Sec. 20 Twp. 9 R. 20E

Well No. 1 Hesse

Hatcher & Fisk

Company

FIRST REPORT

Contractor

C NE SE


SECTION PLAT

660 Ft. from N. Line

_____ Ft. from S. Line

660 Ft. from E. Line

_____ Ft. from W. Line

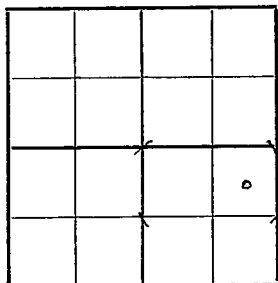

MCLOUTH POOL

RECORD

Location _____

Cased _____ in., _____ ft.

Rig up _____

Sand _____

Drilling and Remarks:

Gas _____

Oil _____

Total Depth _____

Spud

PRODUCTION

1st 24 hrs. Nat. _____

1st 24 hrs. after shot _____

Gas _____ Cu. Ft.

Dry Hole _____

Abandoned _____

Date

JUN 17 1942 19

S. J. LEWIS Scout

Jefferson

KANSAS

Map No. MM Sec. 20 Twp. 9 R. 20EWell No. 1 HesseHatcher & Fisk Company**COMPLETED** Contractor

C N E S E

SECTION PLAT

660 Ft. from N. Line Ft. from S. Line660 Ft. from E. Line Ft. from W. Line

			o

M C L O U T H P O O L

Location _____

Rig up _____

Drilling and Remarks:

*Sand 1400**5" @ 1400**2 3/4 M Gas*

RECORD

Cased _____ in., _____ ft.

Sand _____

Gas _____

Oil _____

Total Depth: 1423

PRODUCTION

1st 24 hrs. Nat. _____

1st 24 hrs. after shot _____

Gas _____ Cu. Ft.

Dry Hole _____

Abandoned _____

Date

JUL 8 1942 19 S. J. LEWIS Scout