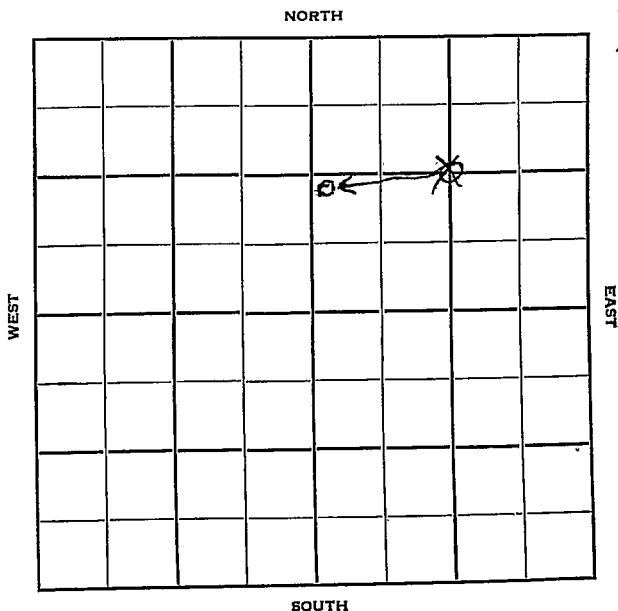


Section 21 Township 9 Range 4EWell No. #1 GlazeCompany Mendenhall et al

KANSAS Clay

Sec. 21 Twp. 9 R. 4-E ✓

Well No. #1 Glaze Farm

Mendenhall etal Company

Mendenhall etal Contractor

Wildcat Well

1450
1320 Ft. from N. Line


_____ Ft. from S. Line

1320 Ft. from E. Line

200' Ft. from W. Line

NW SW NE

~~C-NE~~

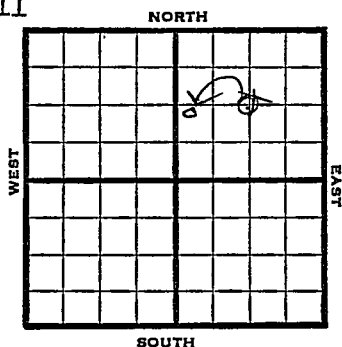

1950

REPORT

2/1

Drlg

2/22

TD 1824'

8 5/8" @ 103'

Miss 1780'

No shows.

D&A

Aband.

ABANDONED

Kansas

Wildcat


Map No. _____ Sec. 21 Twp. 9 R. 4EWell No. 1 Glaze

_____ Mendenhall et al. _____ Company

_____ Mendenhall et al. _____ Contractor

C NE

SECTION PLAT

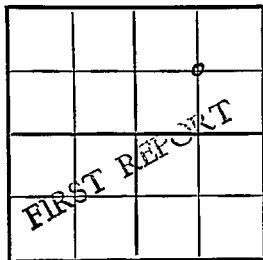1320 Ft. from N. Line

_____ Ft. from S. Line .

1320 Ft. from E. Line

_____ Ft. from W. Line

Clay County

Location _____

Rig up _____

Drilling and Remarks:

drlg.

RECORD

Cased _____ in., _____ ft.

Sand _____

Gas _____

Oil _____

Total Depth _____

PRODUCTION

1st 24 hrs. Nat. _____

1st 24 hrs. after shot _____

Gas _____ Cu. Ft.

Dry Hole _____

Abandoned _____

Date

FEB 1 1950 19J. E. TYRA Scout


Map No. _____ Sec. 21 Twp. 9 R. 4EWell No. 1 Glaze

_____ Mendenhall et al. _____ Company

_____ Contractor

C NE

SECTION PLAT

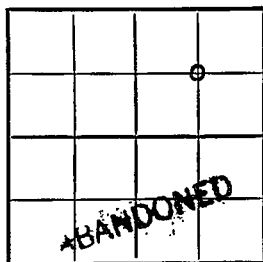1320 Ft. from N. Line

_____ Ft. from S. Line

1320 Ft. from E. Line

_____ Ft. from W. Line

Clay County

Location _____

Rig up _____

Drilling and Remarks:

*8 5/8 @ 103**Miss 1780**T.D. 1824 m**Shows**D + A.*

RECORD

Cased _____ in., _____ ft.

Sand _____

Gas _____

Oil _____

Total Depth _____

..PRODUCTION

1st 24 hrs. Nat. _____

1st 24 hrs. after shot _____

Gas _____ Cu. Ft.

Dry Hole _____

Abandoned _____

Date

FEB 22 1950

19

J. E. TYRA

Scout

KansasMap No. _____ Sec. 21 Twp. 9 R. 4EWell No. 1 GlaceMendenhall etal.

Company _____

CORRECTION

Contractor _____

NW SW NE

El. 1172**SECTION PLAT**1450 Ft. from N. Line

_____ Ft. from S. Line

_____ Ft. from E. Line

200 Ft. from W. Line

		o	

Clay County

Location _____

Rig up _____

Drilling and Remarks:

Completed

Feb. 22, 1951

C NE

RECORD

Cased _____ in., _____ ft.

Sand _____

Gas _____

Oil _____

Total Depth _____

PRODUCTION

1st 24 hrs. Nat. _____

1st 24 hrs. after shot _____

Gas _____ Cu. Ft.

Dry Hole _____

Abandoned _____

Date

MAR 1 4 1951J. E. TYRA

Scout