


15 027 00041 0060

Clay

Form 51-5M-11-31-Palace

Map No. **KANSAS** Sec. 21 Twp. 9 R. 4EWell No. Glaze Farm
Seidel Bros. Company

NORTH

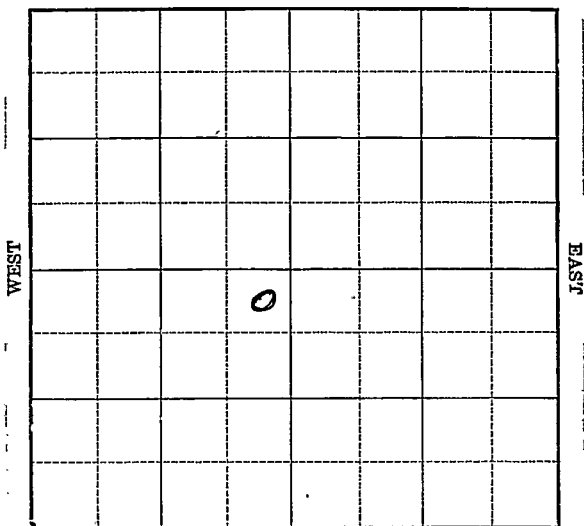

SOUTH

Location _____

Drilling Remarks _____

Rig Up _____

Drilling Remarks _____

RECORD

Cased _____ in. _____ ft.

Sand _____

Gas _____

Oil _____

Total Depth _____

PRODUCTION

1st 24 hrs. Nat. _____


1st 24 hrs. after shot _____

Gas _____ cu. ft.

Dry Hole _____

Abandoned _____

Clay

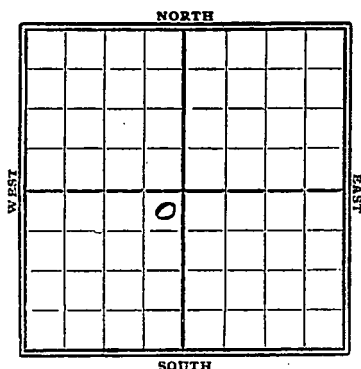Map No. **KANSAS** Sec. 21 Twp. 9 R. 4EWell No. Glace FarmSeidel Bros. Company330 Ft. from N. Line Ft. from S. Line330 Ft. from E. Line Ft. from W. LineDate
1934

REPORT

4/35 Chat 1834 S.O. 1873 Est.5-10 Bble 35 Grav.TD 1874 show W. S.P.5/2 Chat 1834 + TD 1874 2/7 1/2.**ABANDONED**

JAN 31 1935

JAN 31 1935

JAN 31 1935

KANSAS

Map No. 102 Sec. 21 Twp. 9 R. 4EWell No. 1-NeauSeidel Bros. Company

Contractor

SECTION PLAT

FIRST REPORTS

330 Ft. from N. Line

_____ Ft. from S. Line

330 Ft. from E. Line

_____ Ft. from W. Line

	0		

Location _____

Rig up _____

Drilling and Remarks:

Chat 1834
A.O. 1873
Est 5-10 lbs
359 gravity
TD 1874 show W
S.O.

RECORD

Cased _____ in., _____ ft.

Sand _____

Gas _____

Oil _____

Total Depth _____

PRODUCTION

1st 24 hrs. Nat. _____

1st 24 hrs. after shot _____

Gas _____ Cu. Ft.

Dry Hole _____

Abandoned _____

Date

4-25-34 19

ORVAL MANNSCHEIDT

no source
int
was
SP

Returned	
Cards	<i>RD</i>
Tracing	<i>CC</i>
France Map	<i>X</i>
Scarborough Map	<i>X</i>
Moody Map	<i>X</i>
Scarborough Plat Book	
Moody Plat Book	

Map No. 102 Sec. 21 Twp. 9 R. 4EWell No. 1- MeaseReidel Bros Company

Contractor

ABANDONED

SECTION PLAT

330 Ft. from N. Line

_____ Ft. from S. Line

330 Ft. from E. Line

_____ Ft. from W. Line

	0		

Location _____

Rig up _____

Drilling and Remarks:

H. F. W.

RECORD

Cased _____ in., _____ ft.

Sand Chat 1834

Gas _____

Oil _____

Total Depth 1874

PRODUCTION

1st 24 hrs. Nat. _____

1st 24 hrs. after shot _____

Gas _____ Cu. Ft.

Dry Hole _____

Abandoned _____

Date

5-2-34 19

ORVAL MANNSCHRECK

Scout

no *no*

no *no*

[Signature]

[Signature]

Returned	
Cc ds	<i>RR</i>
Tracing	<i>CRK</i>
France Map	<i>X</i>
Scarborough Map	<i>X</i>
Moody Map	<i>X</i>
Scarborough Plat Book	
Moody Plat Book	