


Map No. KANSAS Sec. 21 Twp. 9 R. 4E

Well No. 1 Younken Farm  
Seidel Bros Company

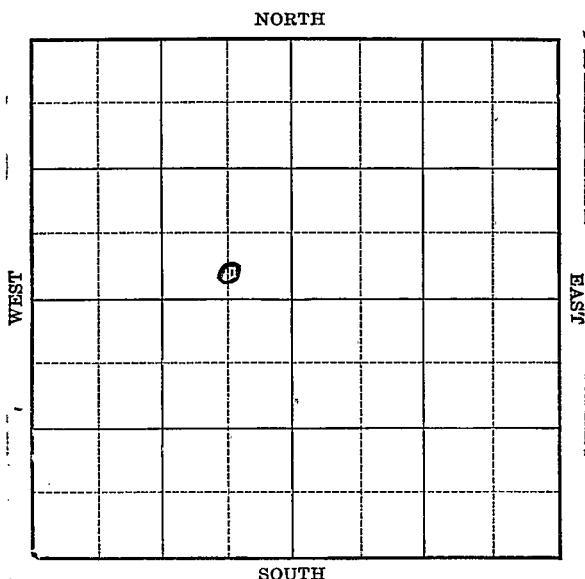

Location \_\_\_\_\_  
 Drilling Remarks \_\_\_\_\_

Rig Up \_\_\_\_\_  
 Drilling Remarks \_\_\_\_\_

**RECORD**

Cased \_\_\_\_\_ in. \_\_\_\_\_ ft.  
 Sand \_\_\_\_\_  
 Gas \_\_\_\_\_  
 Oil \_\_\_\_\_  
 Total Depth \_\_\_\_\_

**PRODUCTION**

1st 24 hrs. Nat. \_\_\_\_\_  
 1st 24 hrs. after shot \_\_\_\_\_  
 Gas \_\_\_\_\_ cu. ft.  
 Dry Hole \_\_\_\_\_  
 Abandoned \_\_\_\_\_

Map No. \_\_\_\_\_ Sec. 21 Twp 9 R. 4E


Well No. 1 Younken Farm  
Seidel Bros. Company

\_\_\_\_\_ Ft. from N. Line

750 Ft. from S. Line

660 Ft. from E. Line

\_\_\_\_\_ Ft. from W. Line

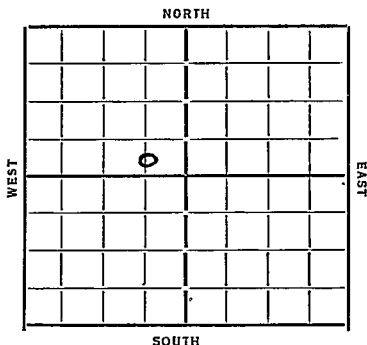

| Date  | REPORT                |
|-------|-----------------------|
| 1924  |                       |
| 5/9   | Machine               |
| 5/18  | Rign up               |
| 5/25  | Spud                  |
| 5/31  | No report             |
| 6/7   | 53' 4 sq.             |
| 6/14  | —                     |
| 6/21  | dely 250              |
| 6/28  | SD 250                |
| 7/5   | 10" 680               |
| 7/12  | Alg 702               |
| 7/19  | " 920                 |
| 7/26  | SD 920                |
| 8/2   | —                     |
| 8/9   | Alg 1200              |
| 8/16  | SD 1200               |
| 8/23  | SD 1225               |
| 8/30  | — 9/6 — 9/13 — 9/20 — |
| 9/27  | Alg 1245              |
| 10/4  | " 1252 8" 1188        |
| 10/11 | —                     |
| 10/18 | 1260 C.O.             |
|       | — OVER —              |

10/25 1300 5D  
11/1 Dly 1353  
11/8 1391 26 R 8"  
11/15 — 11/22 — 11/28 —  
12/6 Dly 1400 8" 1378  
12/13 — 12/21 — 12/27 —  
1/3/35 2D 1400  
1/10 —  
1/17 Dly 1631 6" 1531  
1/24 — 1/31 —  
2/7 Dly 1672  
2/14 " 1730 5" liner 1635  
2/21 —  
2/28 1772 run case  
3/7 —  
3/14 1795 Run liner  
3/21 —  
3/28 Miss L. 1772 TD 1777  
600' O.R.W.  
4/4 prep to acidize  
4/11 1781 H.F.O.  
4/18 —  
4/26 5 oil & 10 Water May acidize  
5/2 — 5/9 — 5/16 — 5/23 —  
5/31 500 Gal acid  
6/6 — 6/13 —

6/20 PB 1773 H.F.W.  
6/28 — 7/3 — 7/11 — 7/18 —  
7/24 T 1778  
D. & A.

ABANDONED

Map No. 1102 Sec. 21 Twp. 9 R. 4E

Well No. 1-1400000

Seidel Bros. Company

Contractor

FIRST REPORTS

SECTION PLAT

\_\_\_\_\_ Ft. from N. Line

250 Ft. from S. Line

660 Ft. from E. Line

\_\_\_\_\_ Ft. from W. Line

|  |  |  |  |
|--|--|--|--|
|  |  |  |  |
|  |  |  |  |
|  |  |  |  |
|  |  |  |  |

Location \_\_\_\_\_

Rig up \_\_\_\_\_

Drilling and Remarks:

Machine

RECORD

Cased \_\_\_\_\_ in., \_\_\_\_\_ ft.

Sand \_\_\_\_\_

Gas \_\_\_\_\_

Oil \_\_\_\_\_

Total Depth \_\_\_\_\_

PRODUCTION

1st 24 hrs. Nat. \_\_\_\_\_

1st 24 hrs. after shot \_\_\_\_\_

Gas \_\_\_\_\_ Cu. Ft.

Dry Hole \_\_\_\_\_

Abandoned \_\_\_\_\_

Date

5-9-34

19

ORVAL MANNSCHRECK

Scout

no west  
no small

|                        |     |
|------------------------|-----|
| Returned               |     |
| Cards                  | RD  |
| Tracing                | CRK |
| F.ance Map             | X   |
| Scarborough Map        | X   |
| Moody Map              | X   |
| Scarboro. gh Plot Book |     |
| Moody, Plot Book       |     |

Map No. 102 Sec. 21 Twp. 9 R. 4EWell No. 1-R. YounkenSeirol Bros. Company

Contractor

ABANDONED

## SECTION PLAT

Ft. from N. Line

250 Ft. from S. Line660 Ft. from E. Line

Ft. from W. Line

|  |   |  |  |
|--|---|--|--|
|  |   |  |  |
|  |   |  |  |
|  | 0 |  |  |
|  |   |  |  |
|  |   |  |  |

Location

Rig up

Drilling and Remarks:

IVA

## RECORD

Cased in, ft.

Sand

Gas

Oil

Total Depth 1778

## PRODUCTION

1st 24 hrs. Nat.

1st 24 hrs. after shot

Gas Cu. Ft.

Dry Hole

Abandoned

Date

7/24/25 192

ORVAL MANNSCHRECK

Scout

Returned *CDL*

Cards *Joe*

Tracing *X*

France Map *X*

Scarborough Map *X*

Moody Map *X*

Scarborough Plat Book

Moody P'at Book