

KANSAS

15 103 380650000


FORM 51 5M PETROL

Leavenworth

Section 21 Township 9 Range 21E

Well No. #1 Karl Scwarger

Company Chas. Miller et al.

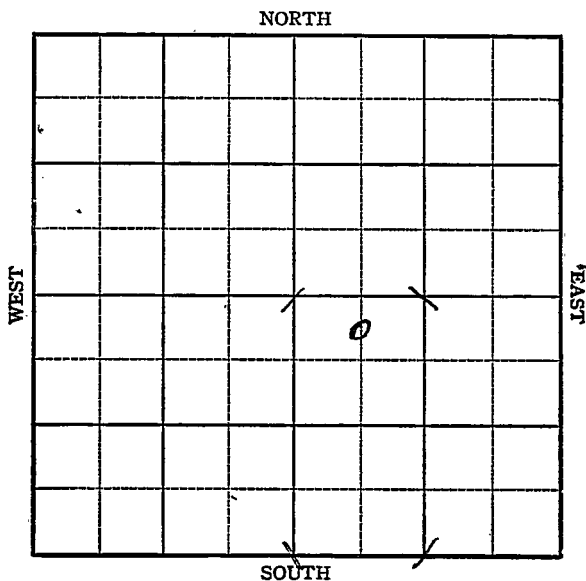

KANSAS

Leavenworth

Sec. 21 Twp. 9 R. 21-E

Well No. #1 Karl Schwager Farm


Chas. Miller et al Company

330 Ft. from N. Line

 Ft. from S. Line

 Ft. from E. Line

660 Ft. from W. Line

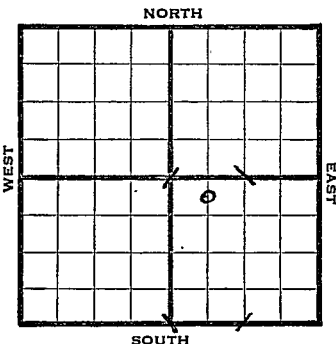

McLouth

1944

871 REPORT

3/15

10" @ 60'
Drlg. 320'

3/22

" "

3/29

8" @ 670
Drlg. 700'

4/5

" "

4/12

" "

4/19

6" @ 1302
Miss 1314
TD 1431

KANSAS

Map No. N M Sec. 21 Twp. 9 R. 21 EWell No. 1 Karl ScwargarChas. Miller et al.


Company

FIRST REPORT

Contractor

C N L NW SE

SECTION PLAT

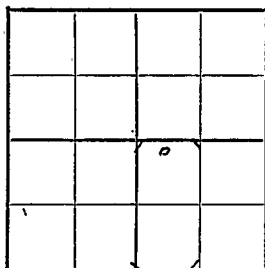330 Ft. from N. Line Ft. from S. Line Ft. from E. Line660 Ft. from W. LineMcLouth PoolLocation Rig up

Drilling and Remarks:

10" - 60'320'

RECORD

Cased in., ft.Sand Gas Oil Total Depth

PRODUCTION

1st 24 hrs. Nat. 1st 24 hrs. after shot Gas Cu. Ft.Dry Hole Abandoned

Date

MAR 15 1944 19S. J. LEWIS Scout

Pool Name McLouth

KANSAS

Map No. MM Sec. 21 Twp. 9 R. 21EWell No. 1 Karl ScwargarChas. Miller etal CompanyABANDONED Contractor

SECTION PLAT

C N L NW SE
330 Ft. from N. Line Ft. from S. Line Ft. from E. Line660 Ft. from W. Line

		o	

Leavenworth County

Location Rig up

Drilling and Remarks:

*Miss 1314**6" @ 1302*

RECORD

Cased in., ft.Sand Gas Oil Total Depth 1481

PRODUCTION

1st 24 hrs. Nat. 1st 24 hrs. after shot Gas Cu. Ft.Dry Hole Abandoned

Date

APR 1 9 1944 19

S. J. LEWIS Scout