


Section 21 Township 9 Range 20-E

Well No. #3 Ralph Edmonds

Company O. J. Connell

McLouth Pool NORTH

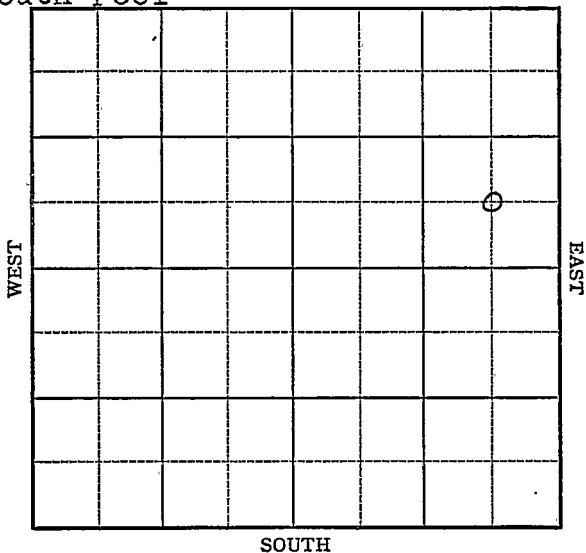


Sec. 21 Twp. 9 R. 20-E

Well No. #3 Ralph Edmonds Farm

O. J. Connell Company

(McLouth Pool)

NORTH

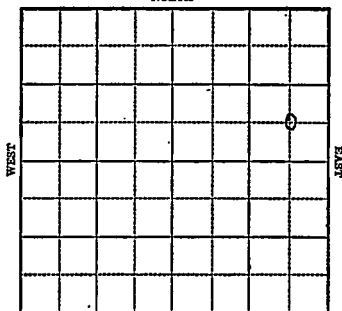

_____ Ft. from N. Line

660 Ft. from S. Line

660 Ft. from E. Line

_____ Ft. from W. Line

1942

R E P O R T

10/7 Spud

10/14 10" @ 150', 8" @ 938'
Drlg. 1065'.

10/21 1440 SDlg

10/28 Miss. 1541 No shows.
T.D. 1545'

ABANDONED

Jefferson KANSAS

Map No. MM Sec. 21 Twp. 9 R. 20EWell No. 3 Ralph EdmondsO. J. Connell

Company

FIRST REPORT

Contractor

C SE NE

SECTION PLAT

			o

_____ Ft. from N. Line

660 Ft. from S. Line660 Ft. from E. Line

_____ Ft. from W. Line

MCLOUTH POOL

Location _____

Rig up _____

Drilling and Remarks:

Spud

RECORD

Cased _____ in., _____ ft.

Sand _____

Gas _____

Oil _____

Total Depth _____

PRODUCTION

1st 24 hrs. Nat. _____

1st 24 hrs. after shot _____

Gas _____ Cu. Ft.

Dry Hole _____

Abandoned _____

Date

OCT 7 1942 19S. J. LEWIS Scout

Map No. AM Sec. 21 Twp. 9 R. 20EWell No. 3 Ralph EdmondsO. J. Connell CompanyABANDONED Contractor

C SE NE

_____ Ft. from N. Line

660 Ft. from S. Line660 Ft. from E. Line

_____ Ft. from W. Line

McLOUTH POOL

SECTION PLAT

			2

Location _____

Rig up _____

Drilling and Remarks:

*Miss 1541**No show*

RECORD

Cased _____ in., _____ ft.

Sand _____

Gas _____

Oil _____

Total Depth 1545

PRODUCTION

1st 24 hrs. Nat. _____

1st 24 hrs. after shot _____

Gas _____ Cu. Ft.

Dry Hole _____

Abandoned _____

Date

OCT 28 1942 19S. J. LEWIS Scout